

Table of Contents	1
Addendum 2 Letter	2
Addendum 2 Plans	3
Addendum 2 Project Special Provisions	10



State of Vermont
Contract Administration
Barre City Place
219 North Main Street, Suite 105
Barre VT 05641
<http://vtrans.vermont.gov>

*Agency of Transportation
Finance & Administration*
[phone] 802-622-1285
[ttd] 800-253-0191

May 15, 2026

CO3275 – Northfield BF 0241(58)

ADDENDUM #2

Bidders:

Changes have been made to the documents located on the Bid Opportunity website as noted below:

REVISED:

Plan Sheet 6, 7, 50, 51, 59, 60, and 75.

Special Provisions Pages 1 and 27

The Schedule of items in the Proposal and Invitation for Bids.

ADDED:

Special Provisions Page 28 and 29

DELETED:

VTrans Mission and Vision

Through excellent customer service, provide for the safe and efficient movement of people and goods.
A safe, reliable, and multimodal transportation system that grows the economy, is affordable to use and operate, and serves vulnerable populations.



QUANTITY SHEET 1

SUMMARY OF ESTIMATED QUANTITIES										TOTALS		DESCRIPTIONS				DETAILED SUMMARY OF QUANTITIES		
	1011 - ROADWAY	1013 - ROADWAY (NO FEDERAL/STA)	1031 - TRAINING	1041 - LANDSCAPING	1051 - EROSION CONTROL	1081 - UTILITIES - BID ITEMS	1083 - UTILITIES - BID ITEMS (NO)	1211 - BRIDGE NO. 1	1999 - FULL C.E. ITEMS	GRAND TOTAL	FINAL	UNIT	ITEMS	ITEM NUMBER	ROUND	QUANTITIES	UNIT	ITEMS
								225000		225000		DL	INCENTIVE OR DISINCENTIVE (N.A.B.I.)	199.8101				
	1									1		LS	CLEARING AND GRUBBING, INCLUDING INDIVIDUAL TREES AND STUMPS	201.1000				
	1200									1200		CY	COMMON EXCAVATION	203.1500				
	134									134		CY	SOLID ROCK EXCAVATION	203.1600				
	15									15		CY	UNCLASSIFIED EXCAVATION	203.1700				
	1950									1950		CY	UNCLASSIFIED CHANNEL EXCAVATION	203.2700				
	1000									1000		CY	TRENCH EXCAVATION OF EARTH	204.2000				
	1									1		CY	TRENCH EXCAVATION OF ROCK	204.2100				
	1									1		CY	TRENCH EXCAVATION OF EARTH, EXPLORATORY (N.A.B.I.)	204.2200				
								940		940		CY	STRUCTURE EXCAVATION	204.2500				
								760		760		CY	GRANULAR BACKFILL FOR STRUCTURES	204.3000				
	230									230		SY	COARSE-MILLING, BITUMINOUS PAVEMENT	210.1000				
								376		376		LF	SOLDIER PILES FOR SOLDIER PILE AND LAGGING WALL	225.0300002				
								306		306		LF	DRILLED HOLE IN EARTH FOR SOLDIER PILE AND LAGGING WALL	225.0300003				
								70		70		LF	DRILLED HOLE IN ROCK FOR SOLDIER PILE AND LAGGING WALL	225.0300004				
								425		425		SF	TIMBER LAGGING FOR SOLDIER PILE AND LAGGING WALL	225.0300005				
								591		591		SF	CONCRETE FACING FOR SOLDIER PILE AND LAGGING WALL	225.0300006				
								1		1		LS	RETAINING WALL, CONCRETE (WINGWALL 1)	225.0500				
								1		1		LS	RETAINING WALL, CONCRETE (WINGWALL 4)	225.0500				
		145792								145792		DL	DISPOSAL OF CONTAMINATED MATERIALS (N.A.B.I.) ((PCF)(N.A.B.I.))	230.0010				
	538624									538624		DL	DISPOSAL OF CONTAMINATED MATERIALS (N.A.B.I.) (DEVELOPMENT SOL)	230.0010				
	500									500		CY	REUSE OF CONTAMINATED MATERIALS	230.0020				
	1									1		LS	PROJECT OPERATIONS PLAN	230.0030				
△	1									1		LS	PROJECT OPERATIONS COMPLETION REPORT (EARTH CRUSHING FOR DISPOSAL ACC)	230.0040				
	1									1		LS	PROJECT OPERATIONS COMPLETION REPORT	230.0040				
		240								240		HR	ENVIRONMENTAL OVERSIGHT ((PCF))	230.0050				
	240									240		HR	ENVIRONMENTAL OVERSIGHT ((NON-PCF))	230.0050				
		1								1		LS	MANAGEMENT OF CONTAMINATED GROUNDWATER (PCF)	230.0060				
					1					1		LS	TEMPORARY ACCESS ROAD	240.0100				
					1					1		LS	TEMPORARY CAUSEWAY	240.0200				
								1		1		LS	CONSTRUCTION VIBRATION AND CRACK MONITORING	250.0100				
	848									848		CY	SUBBASE OF DENSE GRADED CRUSHED STONE	301.3500				
	100									100		CWT	TACK COAT, EMULSIFIED ASPHALT	404.1100				
	155									155		TON	BITUMINOUS CONCRETE PAVEMENT, TYPE IIS, QA TIER III	406.0230				
	136									136		TON	BITUMINOUS CONCRETE PAVEMENT, TYPE IIS, QA TIER III	406.0330				
	220									220		TON	BITUMINOUS CONCRETE PAVEMENT, TYPE IVS, QA TIER III	406.0430				
	310									310		SY	BITUMINOUS CONCRETE PAVEMENT, NON-PAVER PLACED, TYPE IVS	406.3400				
	1									1		DL	PAY ADJUSTMENT, BCP, MIXTURE PROPERTIES (N.A.B.I.)	406.9100				
	1									1		DL	PAY ADJUSTMENT, BCP, MAT DENSITY (N.A.B.I.)	406.9200				
								355		355		CY	PERFORMANCE-BASED CONCRETE, CLASS PCD	501.3700				

ADDENDUM	REVISION	PLOT DATE	DESCRIPTION	BY
△	1	14-MAY-2026	QUANTITY REVISED	S. BROWN



PROJECT NAME: NORTHFIELD
 PROJECT NUMBER: BF 024I(58)
 FILE NAME: z19j223quantities.dgn
 PROJECT LEADER: K. SMITH
 DESIGNED BY: S. BROWN
 QUANTITY SHEET 1

PLOT DATE: 5/14/2026
 DRAWN BY: C. JAMISON
 CHECKED BY: K. SMITH
 SHEET 6 OF 108

QUANTITY SHEET 2

SUMMARY OF ESTIMATED QUANTITIES										TOTALS		DESCRIPTIONS				DETAILED SUMMARY OF QUANTITIES			
1011 - ROADWAY	1013 - ROADWAY (NO FEDERAL/STA)	1031 - TRAINING	1041 - LANDSCAPING	1051 - EROSION CONTROL	1081 - UTILITIES - BID ITEMS	1083 - UTILITIES - BID ITEMS (NO	1211 - BRIDGE NO. 1	1999 - FULL C.E. ITEMS			GRAND TOTAL	FINAL	UNIT	ITEMS	ITEM NUMBER	ROUND	QUANTITIES	UNIT	ITEMS
							145			145			CY	PERFORMANCE-BASED CONCRETE, CLASS PCS	501.3800				
							364			364			LF	STEEL PILING, HP 12 x 84	505.1650				
							335100			335100			LB	STRUCTURAL STEEL, PLATE GIRDER	506.5500				
							7800			7800			LB	REINFORCING STEEL, LEVEL I	507.1100				
							96300 107200			96300 107200			LB	REINFORCING STEEL, LEVEL II	507.1200				
							6144			6144			SF	CONCRETE BRIDGE DECK SURFACE PREPARATION	509.1500				
							5568			5568			SF	PRESTRESSED CONCRETE DECK PANELS	510.4000				
							106			106			GAL	WATER REPELLENT, SILANE	514.1000				
							76			76			LF	BRIDGE EXPANSION JOINT, ASPHALTIC PLUG	516.1000				
							76			76			LF	JOINT SEALER, HOT POURED	524.1100				
							329			329			LF	BRIDGE RAILING, TEXAS RAIL WITH WINDOWS	525.5200				
							1			1			EACH	PARTIAL REMOVAL OF STRUCTURE	529.2000				
							79			79			CY	CONCRETE, CLASS SCC	541.2800				
2										2			CY	FLOWABLE FILL	541.4500				
							224			224			LF	PRE-EXCAVATION OF ABUTMENT PILES, EARTH	546.1000				
							98			98			LF	PRE-EXCAVATION OF ABUTMENT PILES, ROCK	546.2000				
							30			30			LF	PRE-EXCAVATION FOR PILES OBSTRUCTION DRILLING AND REMOVAL	546.3000				
							1			1			LS	FURNISHING EQUIPMENT FOR PRE-EXCAVATION FOR PILES	546.4000				
111										111			LF	24 INCH CPEP	601.0920				
70										70			LF	30 INCH CPEP(SL)	601.2625				
63										63			LF	36 INCH CPEP(SL)	601.2630				
1										1			EACH	30 INCH CPEPES	601.7025				
1										1			EACH	36 INCH CPEPES	601.7030				
2										2			EACH	PRECAST REINFORCED CONCRETE DI WITH CAST IRON GRATE	604.1800				
5										5			EACH	PRECAST REINFORCED CONCRETE CATCH BASIN WITH CAST IRON GRATE	604.2000				
2										2			EACH	CHANGING ELEVATION OF DIS, CATCH BASINS, OR MANHOLES	604.4000				
						1				1			EACH	CHANGING ELEVATION OF SEWER MANHOLES	604.4200				
3										3			EACH	CAST IRON GRATE WITH FRAME, TYPE D	604.4504				
156										156			LF	UNDERDRAIN PIPE, 6 INCH	605.1006				
							180			180			CY	E-STONE FILL, TYPE I	613.0601				
							240			240			CY	E-STONE FILL, TYPE IV	613.0604				
							840			840			CY	STONE FILL, TYPE IV	613.1004				
						1				1			EACH	TEMPORARY RELOCATION OF STREAM	614.1000				
280										280			LF	VERTICAL GRANITE CURB	616.2100				
33										33			LF	REMOVING AND RESETTING CURB	616.4000				
37										37			LF	REMOVAL OF EXISTING CURB	616.4100				
170										170			SY	PORTLAND CEMENT CONCRETE SIDEWALK, 5 INCH	618.1005				
61										61			SY	PORTLAND CEMENT CONCRETE SIDEWALK, 8 INCH	618.1008				
25										25			SF	DETECTABLE WARNING SURFACE	618.3000				

ADDENDUM	REVISION	PLOT DATE	DESCRIPTION	BY
△	1	14-MAY-2026	QUANTITY REVISED	S. BROWN



PROJECT NAME: NORTHFIELD

PROJECT NUMBER: BF 0241(58)

FILE NAME: z19j223quantities.dgn

PROJECT LEADER: K. SMITH

DESIGNED BY: S. BROWN



QUANTITY SHEET 2

PLOT DATE: 5/14/2026

DRAWN BY: C. JAMISON

CHECKED BY: K. SMITH

SHEET 7 OF 108

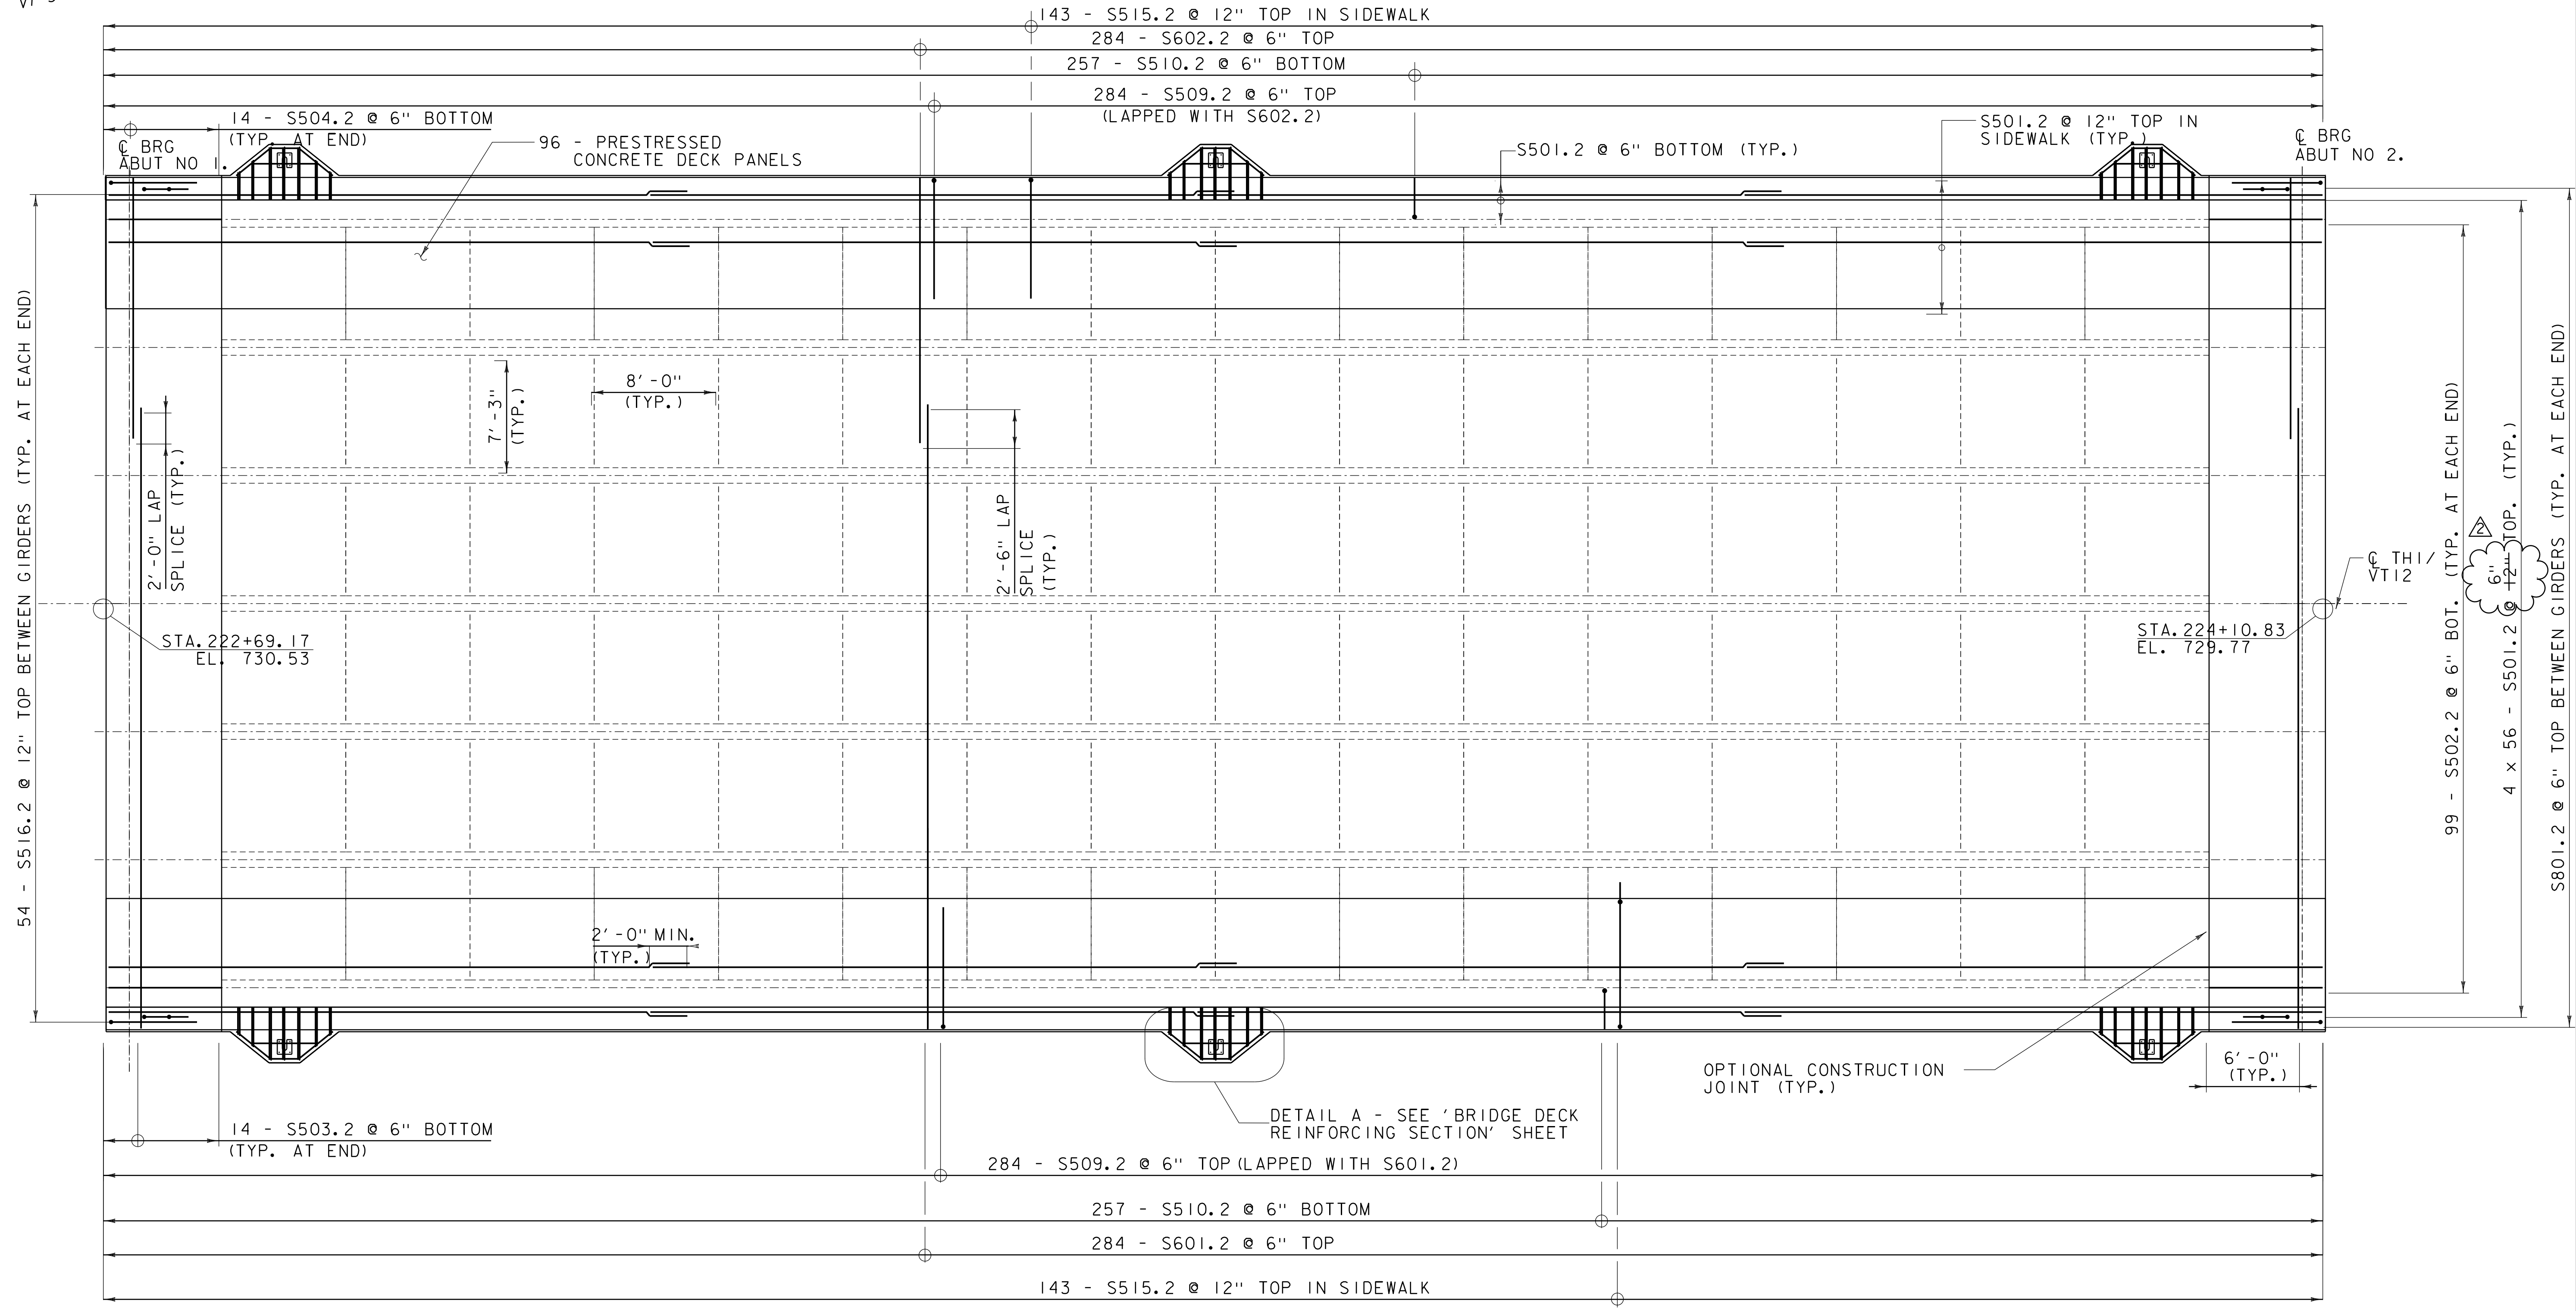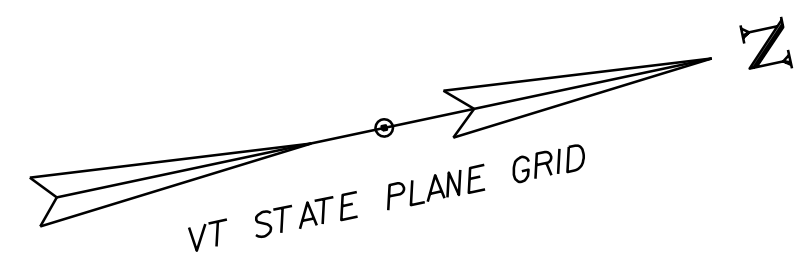

NOTES:

1. BRIDGE RAIL REINFORCEMENT NOT SHOWN FOR CLARITY. SEE 'BRIDGE RAILING DETAILS 1' AND 'BRIDGE RAILING DETAILS 2' FOR BRIDGE RAIL REINFORCEMENT DETAILS.
2. SEE 'ABUTMENT 1 REINFORCEMENT' AND 'ABUTMENT 2 REINFORCEMENT' FOR STEM REINFORCEMENT DETAILS.


DECK REINFORCEMENT PLAN

SCALE: 3/16" = 1' 0"

ADDENDUM	REVISION	PLOT DATE	DESCRIPTION	BY
△	1	14-MAY-2026	REINFORCING REVISED	S. BROWN




PROJECT NAME: NORTHFIELD	
PROJECT NUMBER: BF 0241(58)	
FILE NAME: z19j223sup.dgn	PLOT DATE: 5/14/2026
PROJECT LEADER: K. SMITH	DRAWN BY: C. JAMISON
DESIGNED BY: N. BOB	CHECKED BY: K. SMITH
BRIDGE DECK PLAN	SHEET 50 OF 108

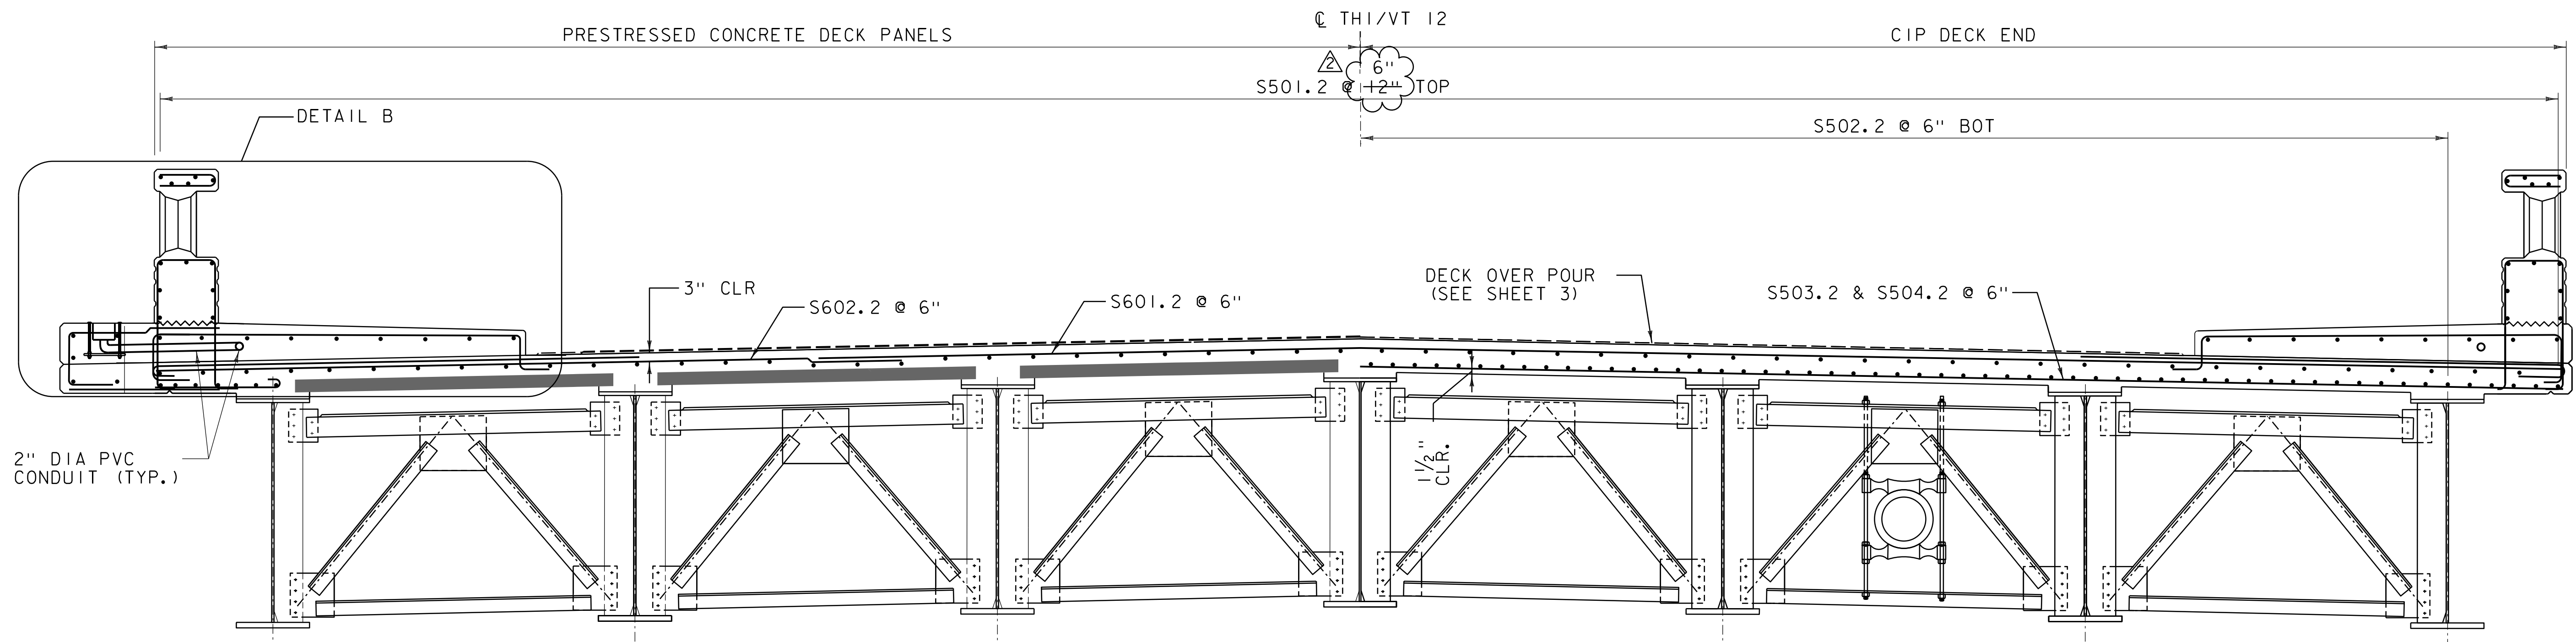


DECK REINFORCING SECTION

SCALE: 1/2" = 1' 0"

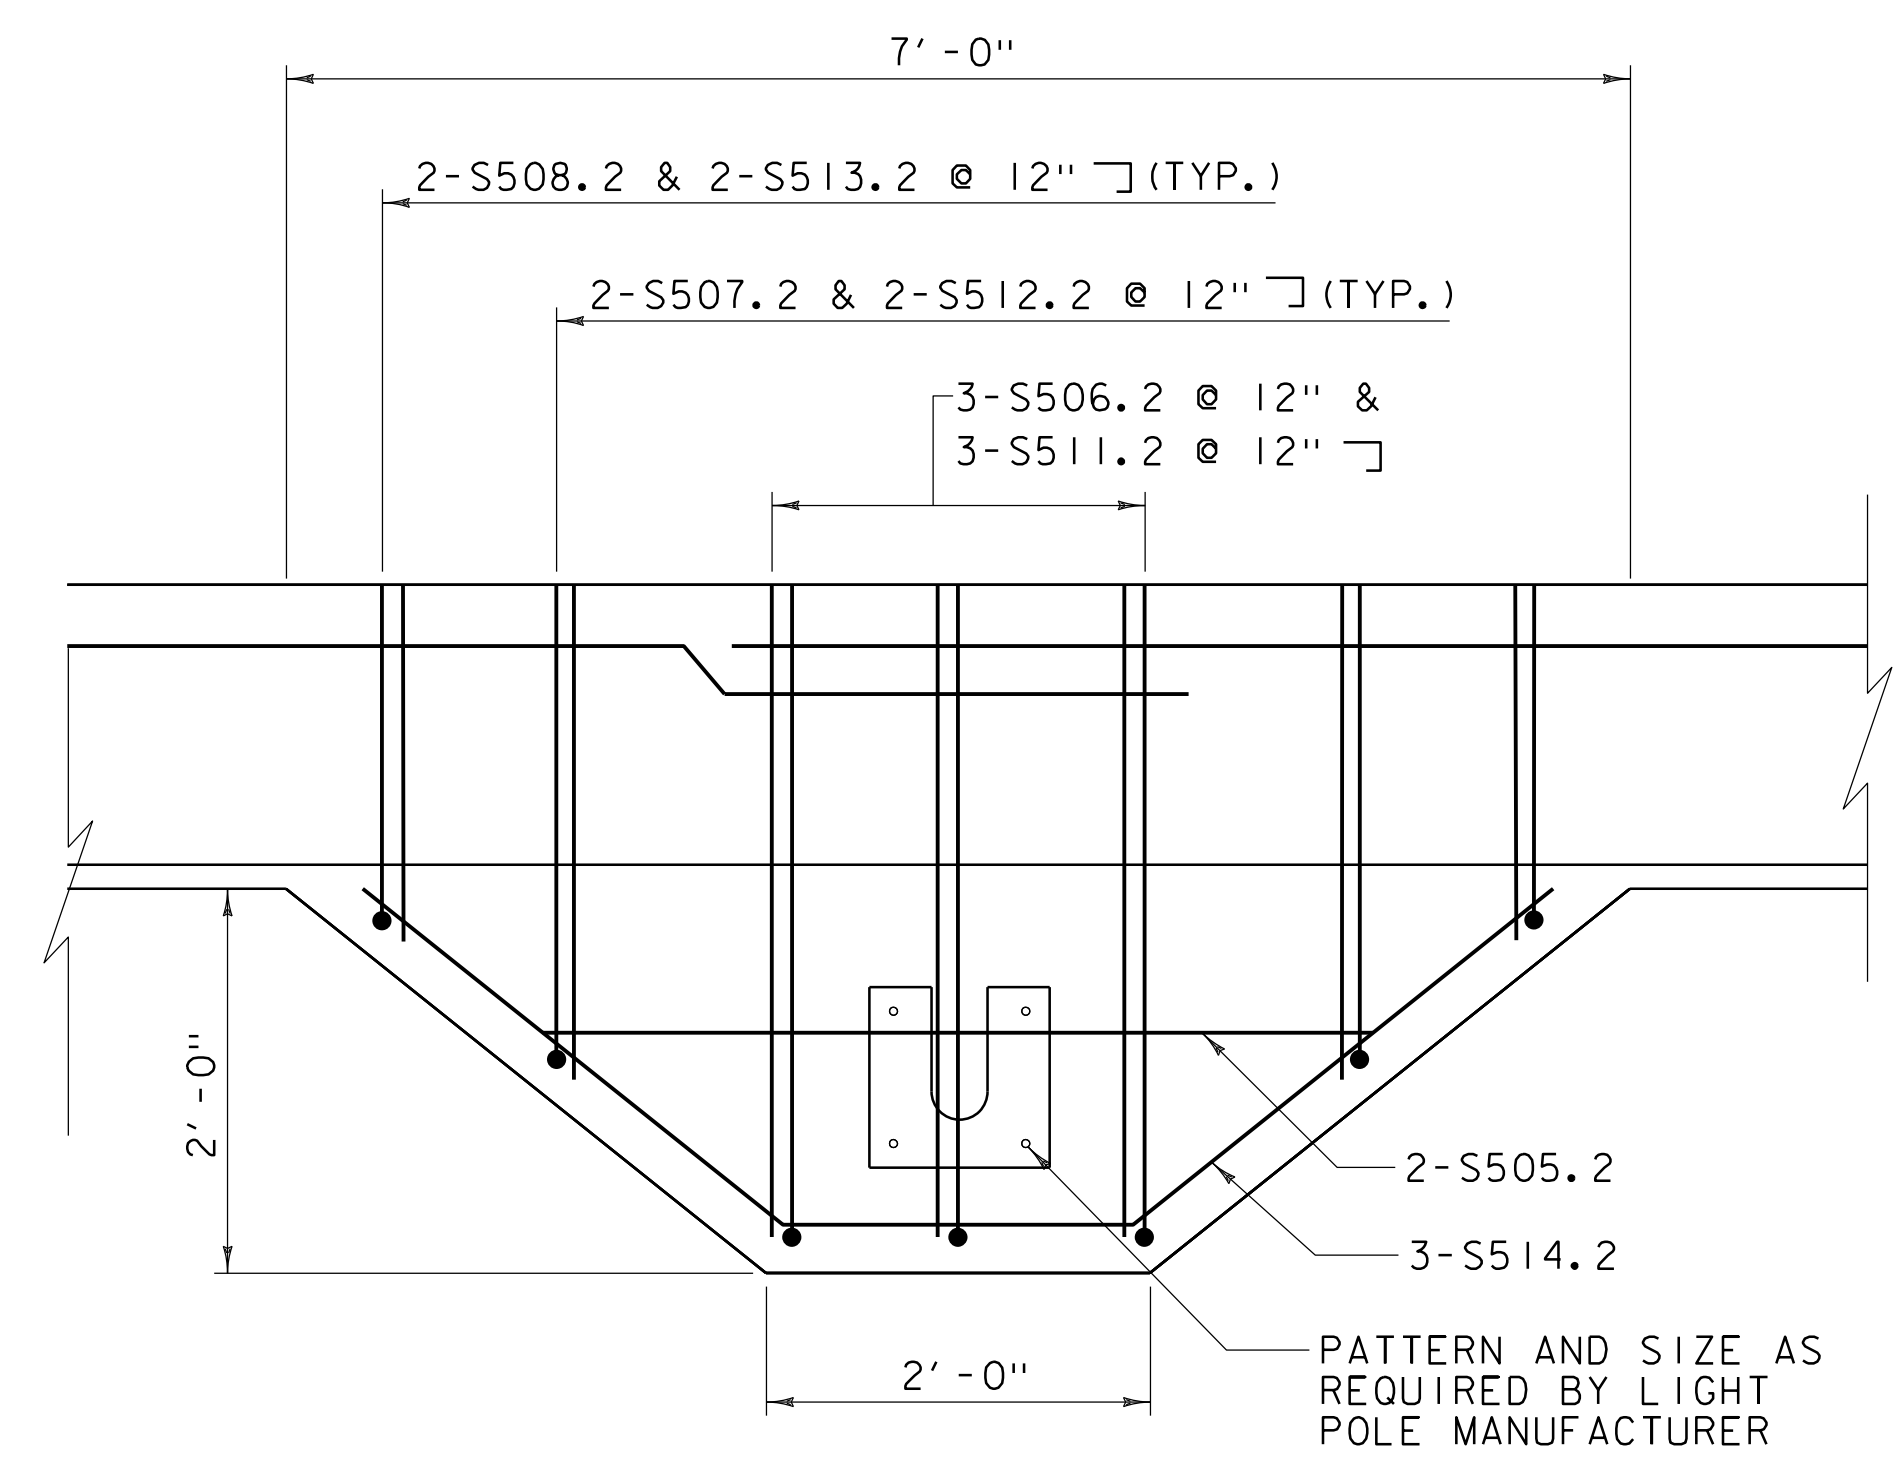

DETAIL A


SCALE: 1" = 1' 0"

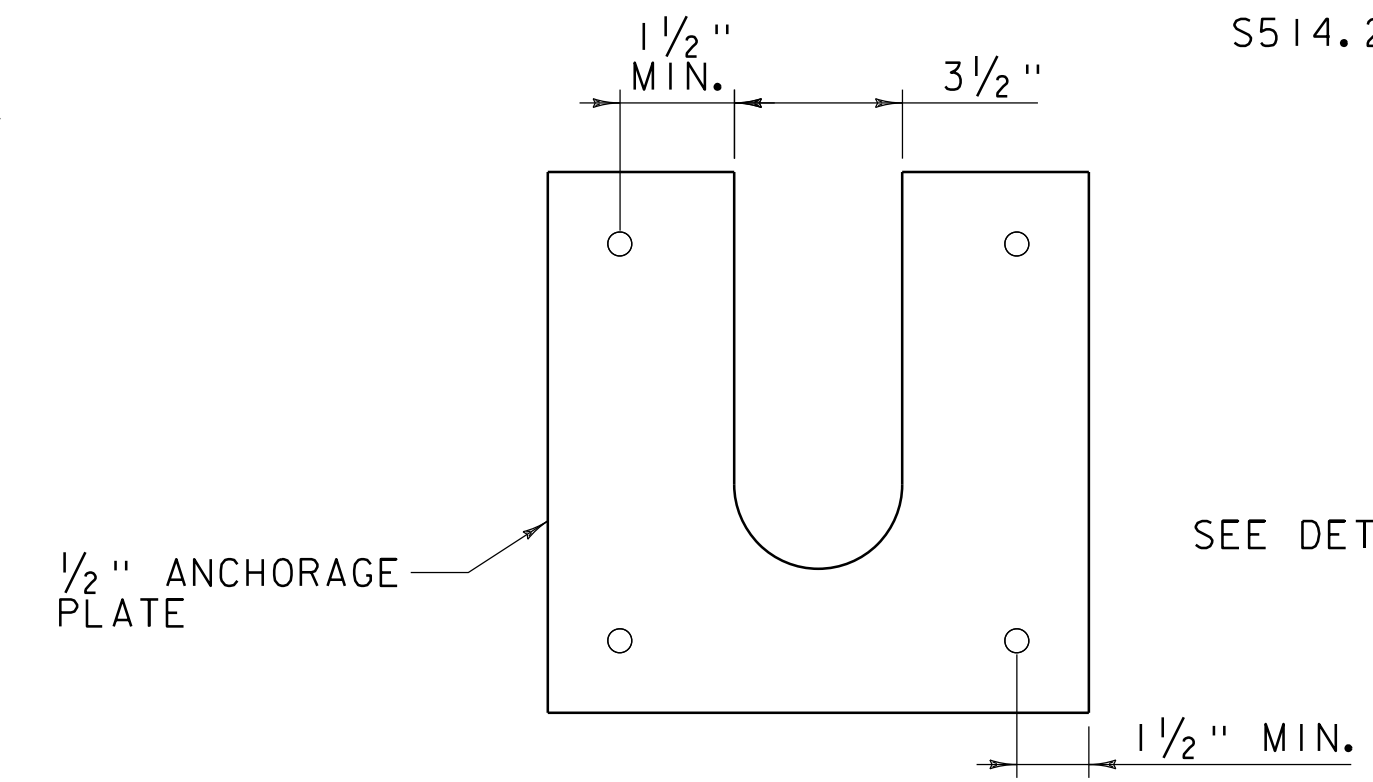

EMBEDDED LIGHT POLE ANCHORAGE PLATE DETAIL


SCALE: 3" = 1' 0"

SHEAR KEY FOR OPTIONAL DECK END CONSTRUCTION JOINT (SEE NOTE 4)

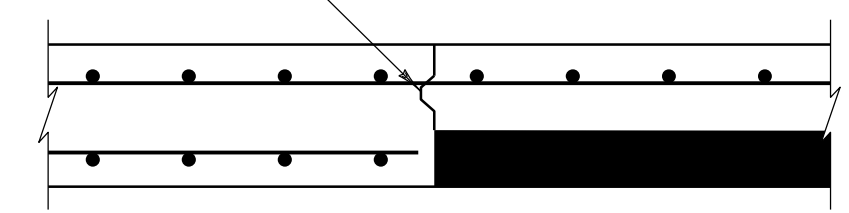

DECK END CONSTRUCTION JOINT DETAIL

SCALE: 1" = 1' 0"

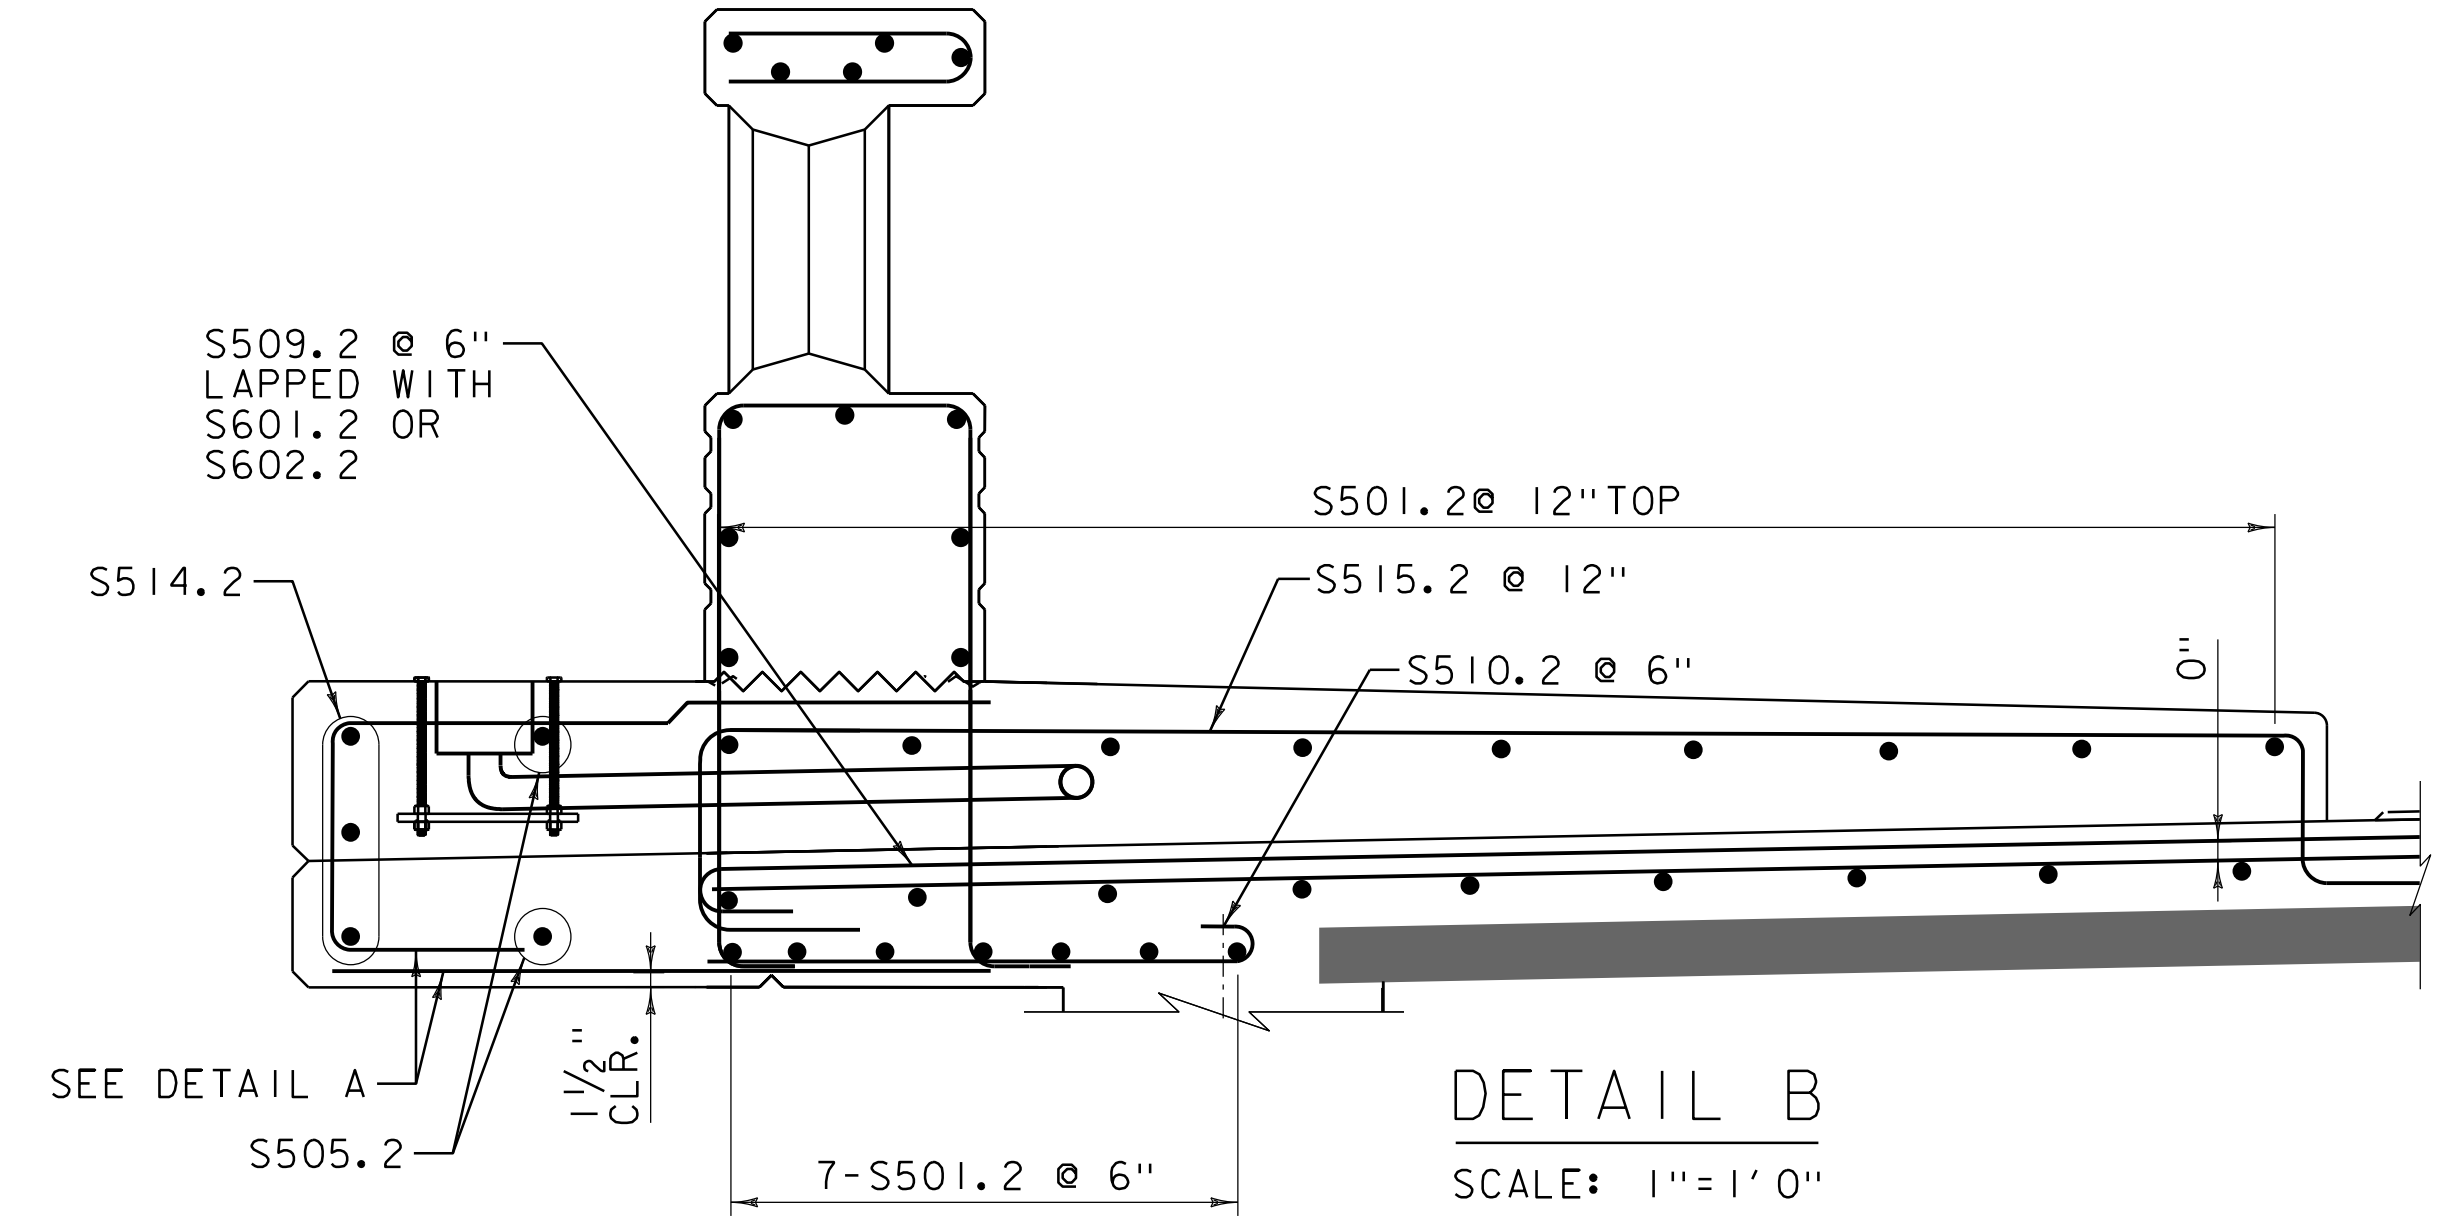

DETAIL B

SCALE: 1" = 1' 0"


NOTES:

1. SEE DRAWING 'BRIDGE RAILING DETAILS 1' AND 'BRIDGE RAILING DETAILS 2' FOR BRIDGE RAILING REINFORCEMENT DETAILS.
2. CLEAR COVER TO REINFORCEMENT OF 3" UNLESS NOTED OTHERWISE.
3. SEE DRAWING 'BRIDGE DECK PLAN' FOR LOCATION OF DETAIL A
4. SEE NOTE 28 ON 'GENERAL NOTES SHEET' FOR OPTIONAL DECK CONSTRUCTION JOINTS.


ADDENDUM	REVISION	PLOT DATE	DESCRIPTION	BY
△	I	14-MAY-2026	REINFORCING REVISED	S. BROWN




PROJECT NAME: NORTHFIELD	PLOT DATE: 5/14/2026
PROJECT NUMBER: BF 024I(58)	DRAWN BY: C. JAMISON
FILE NAME: z19j223sup.dgn	DESIGNED BY: N. BOB
PROJECT LEADER: K. SMITH	CHECKED BY: K. SMITH
BRIDGE DECK REINFORCING SECTION	SHEET 51 OF 108

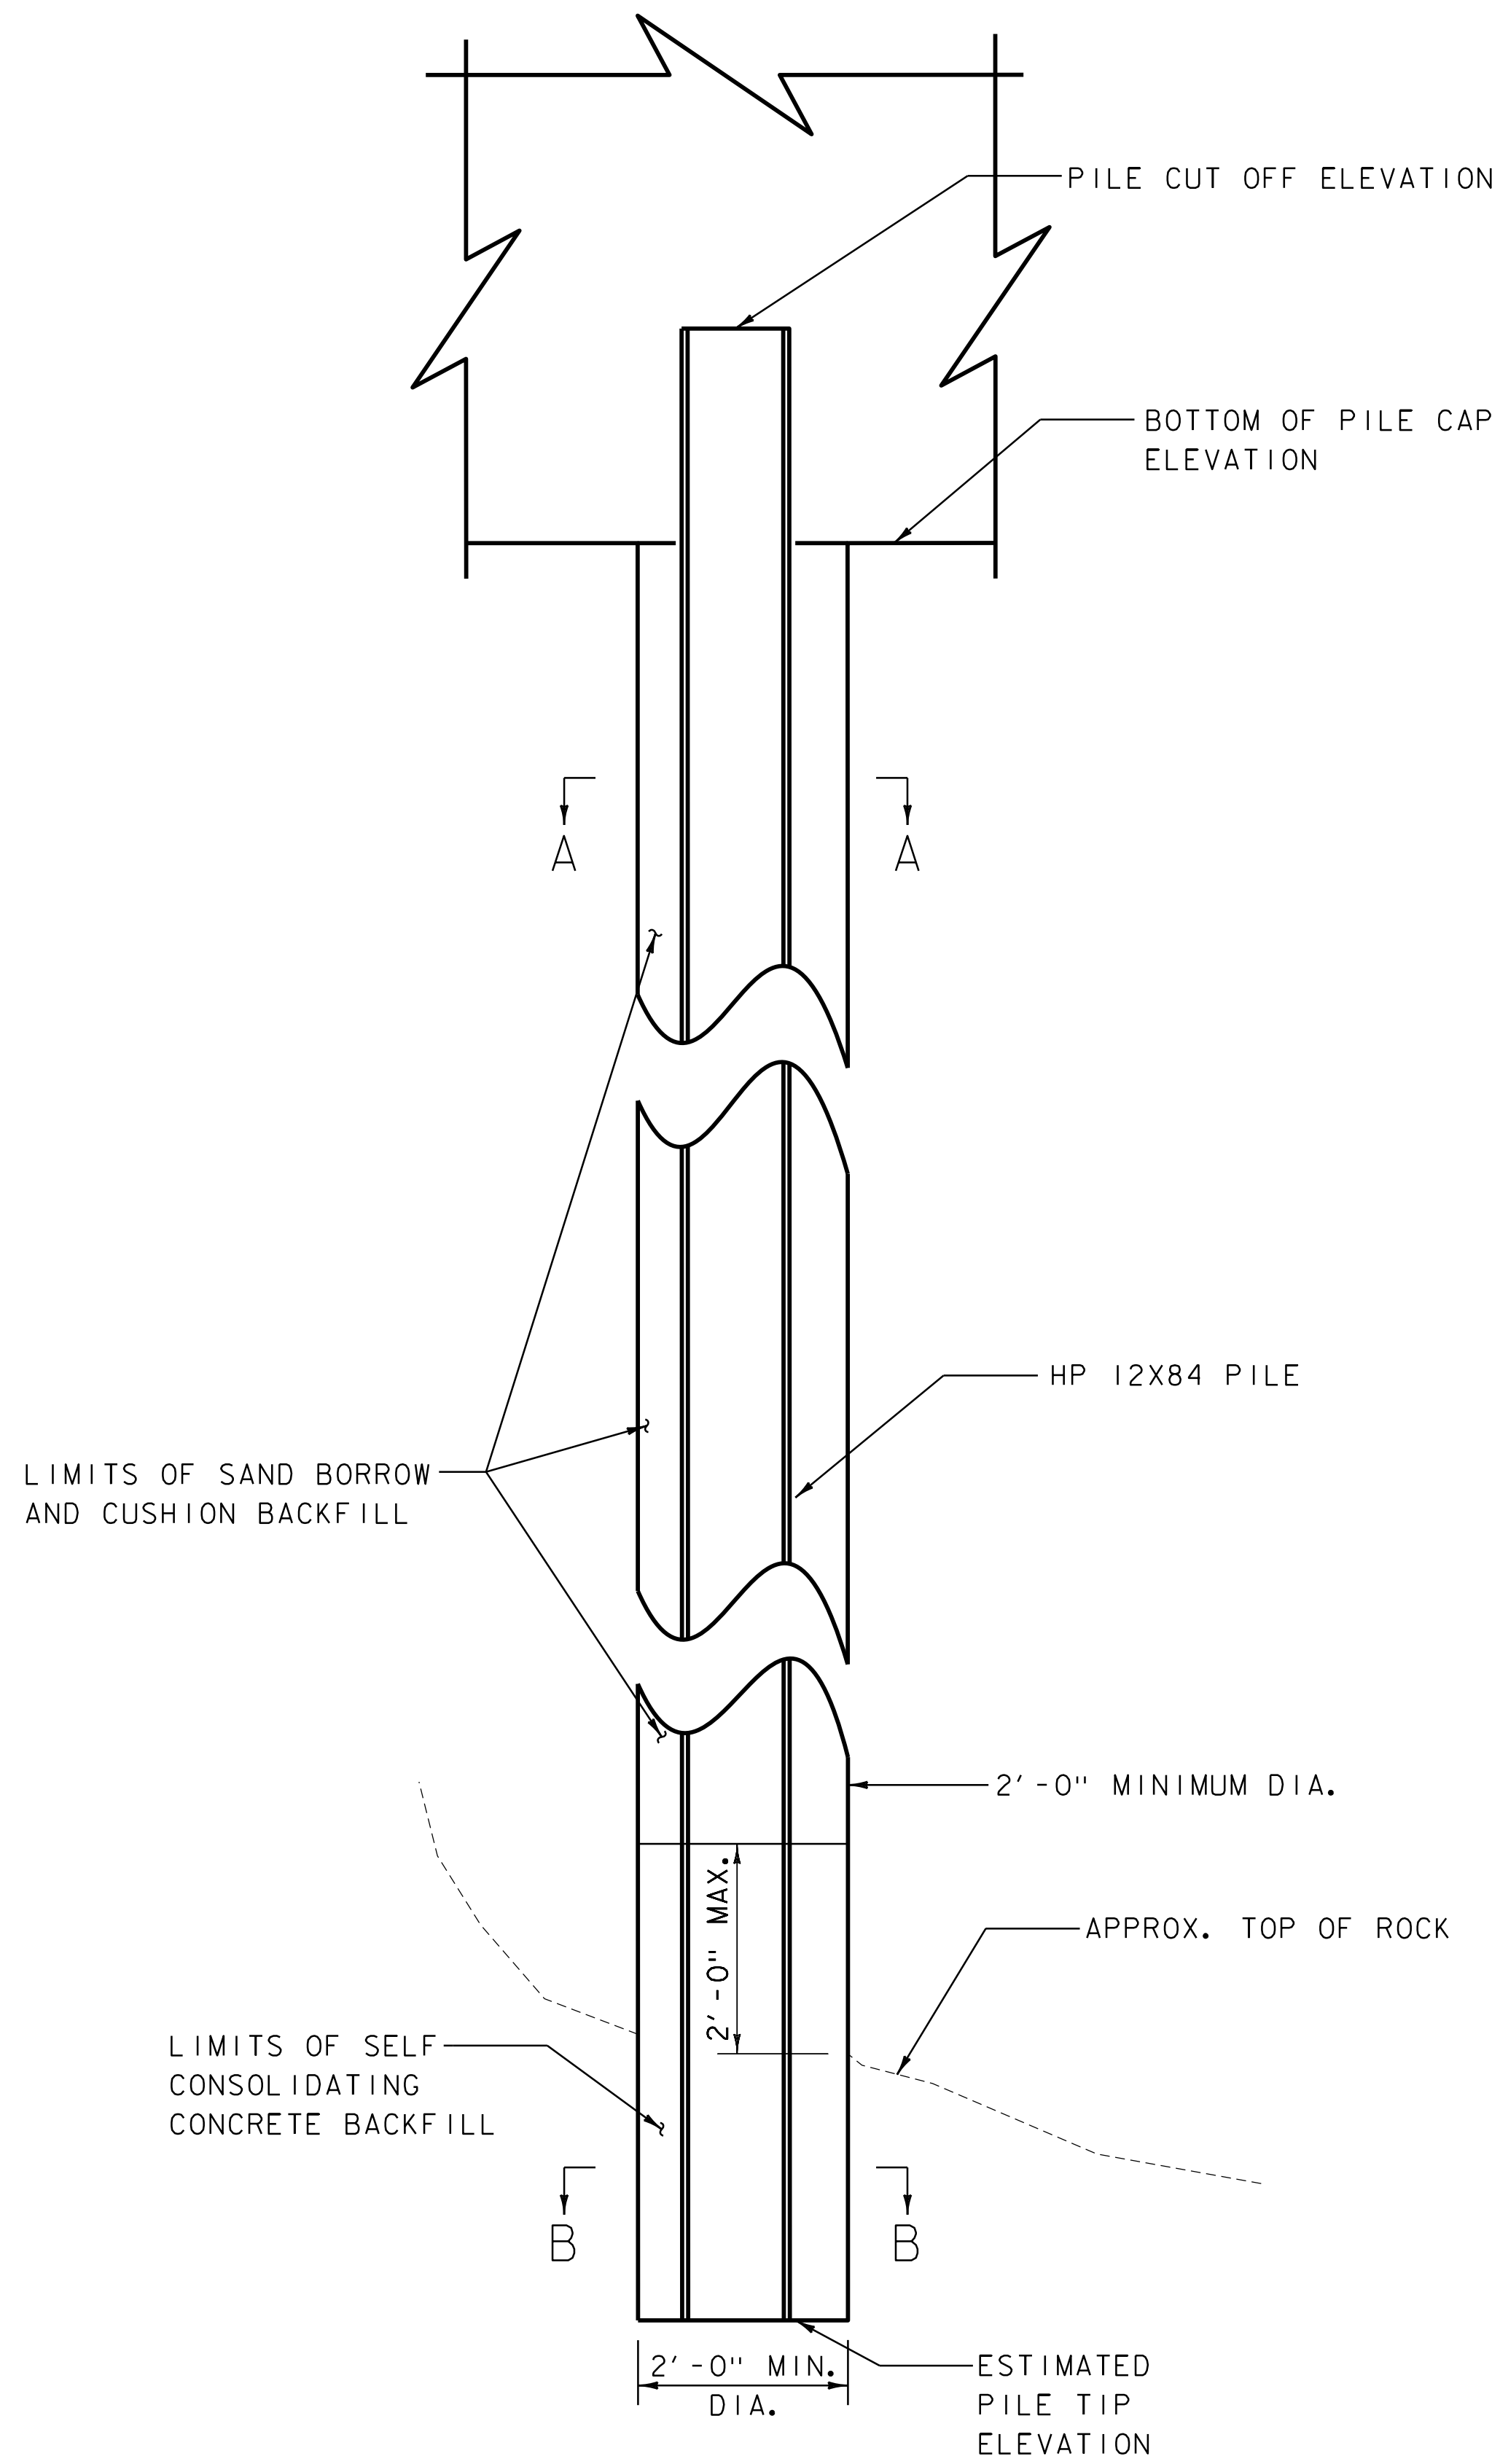

TYPICAL ABUTMENT PILE SOCKET DETAIL
(NOT TO SCALE)

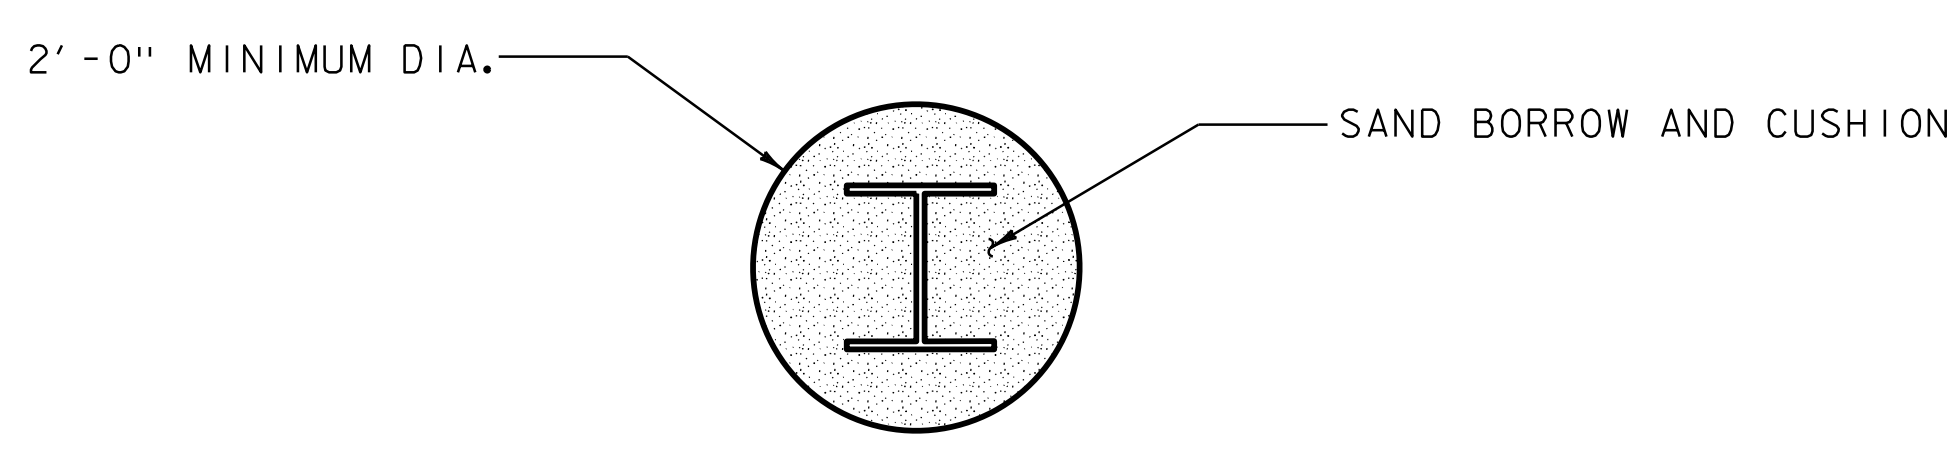

SECTION A-A
(NOT TO SCALE)

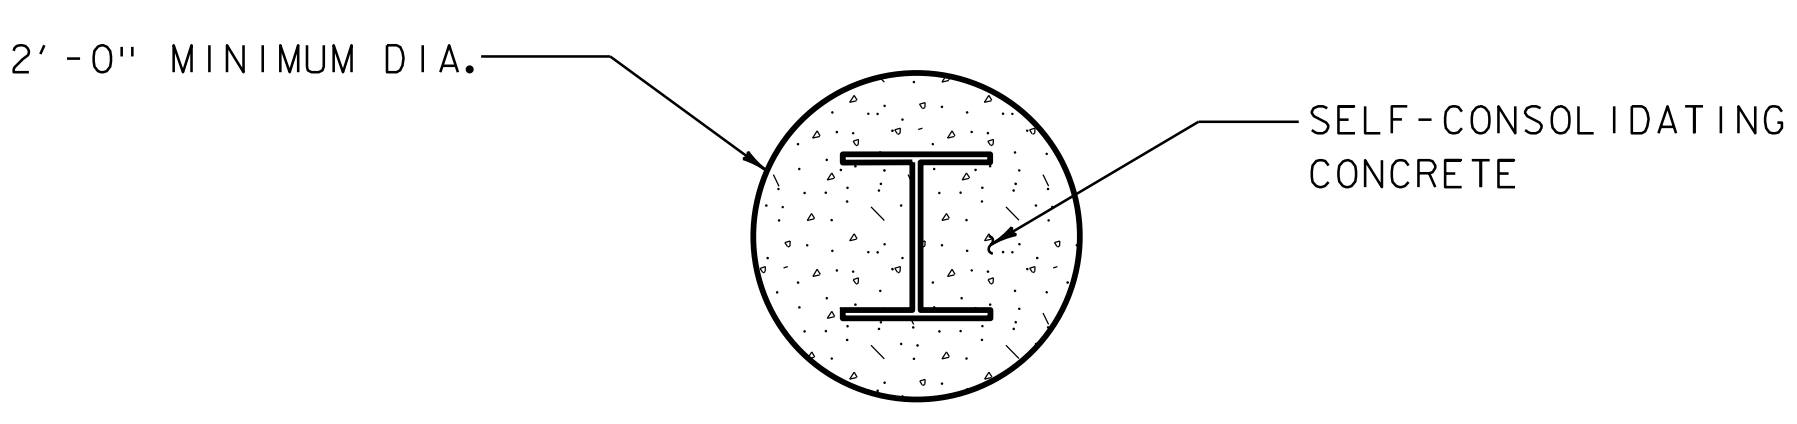

SECTION B-B
(NOT TO SCALE)

NOTES:


1. FOR WINGWALL PILE INFORMATION REFER TO 'WINGWALL PILE DETAIL SHEET'.
2. THE CONTRACTOR SHALL IMMEDIATELY NOTIFY THE ENGINEER IF ACTUAL TOP OF ROCK ELEVATIONS ARE OUTSIDE THE RANGES SHOWN IN THE ABUTMENT PILE SUMMARY TABLE.
3. PILES WILL BE PLACED WITHIN THE PRE-EXCAVATED PILE SOCKETS, BASES CAST INTO CONCRETE, AND BACKFILLED UTILIZING SPECIFIED MATERIALS. SEATING THE PILES INTO THE BEDROCK SOCKETS WITH AN IMPACT PILE DRIVING HAMMER IS NOT REQUIRED.

ABUTMENT PILE SUMMARY TABLE									
SUBSTRUCTURE UNIT	PILE SIZE	MIN. DRILL HOLE DIA. (FT)	ESTIMATED TOP OF ROCK ELEVATION (FT)		REQUIRED ROCK SOCKET LENGTH (FT)	ESTIMATED PILE TIP ELEVATION (FT)		PILE CUTOFF ELEVATION (FT)	NOMINAL AXIAL PILE DRIVING RESISTANCE (RNDR) (KIP)
			FROM	TO		FROM	TO		
ABUTMENT 1	HP 12x84	2	698.5	700.3	7	691.5	693.3	719.5	491
ABUTMENT 2	HP 12x84	2	701.6	706.0	7	694.6	699.0	718.5	493



ADDENDUM	REVISION	PLOT DATE	DESCRIPTION	BY
△	1	14-MAY-2026	NOTE ADDED	S. BROWN



PROJECT NAME: NORTHFIELD
 PROJECT NUMBER: BF 0241(58)
 FILE NAME: z19j223h_pile_grouting.dgn PLOT DATE: 5/14/2026
 PROJECT LEADER: K. SMITH DRAWN BY: C. JAMISON
 DESIGNED BY: S. BROWN CHECKED BY: K. SMITH
 ABUTMENT PILE DETAIL SHEET SHEET 59 OF 108

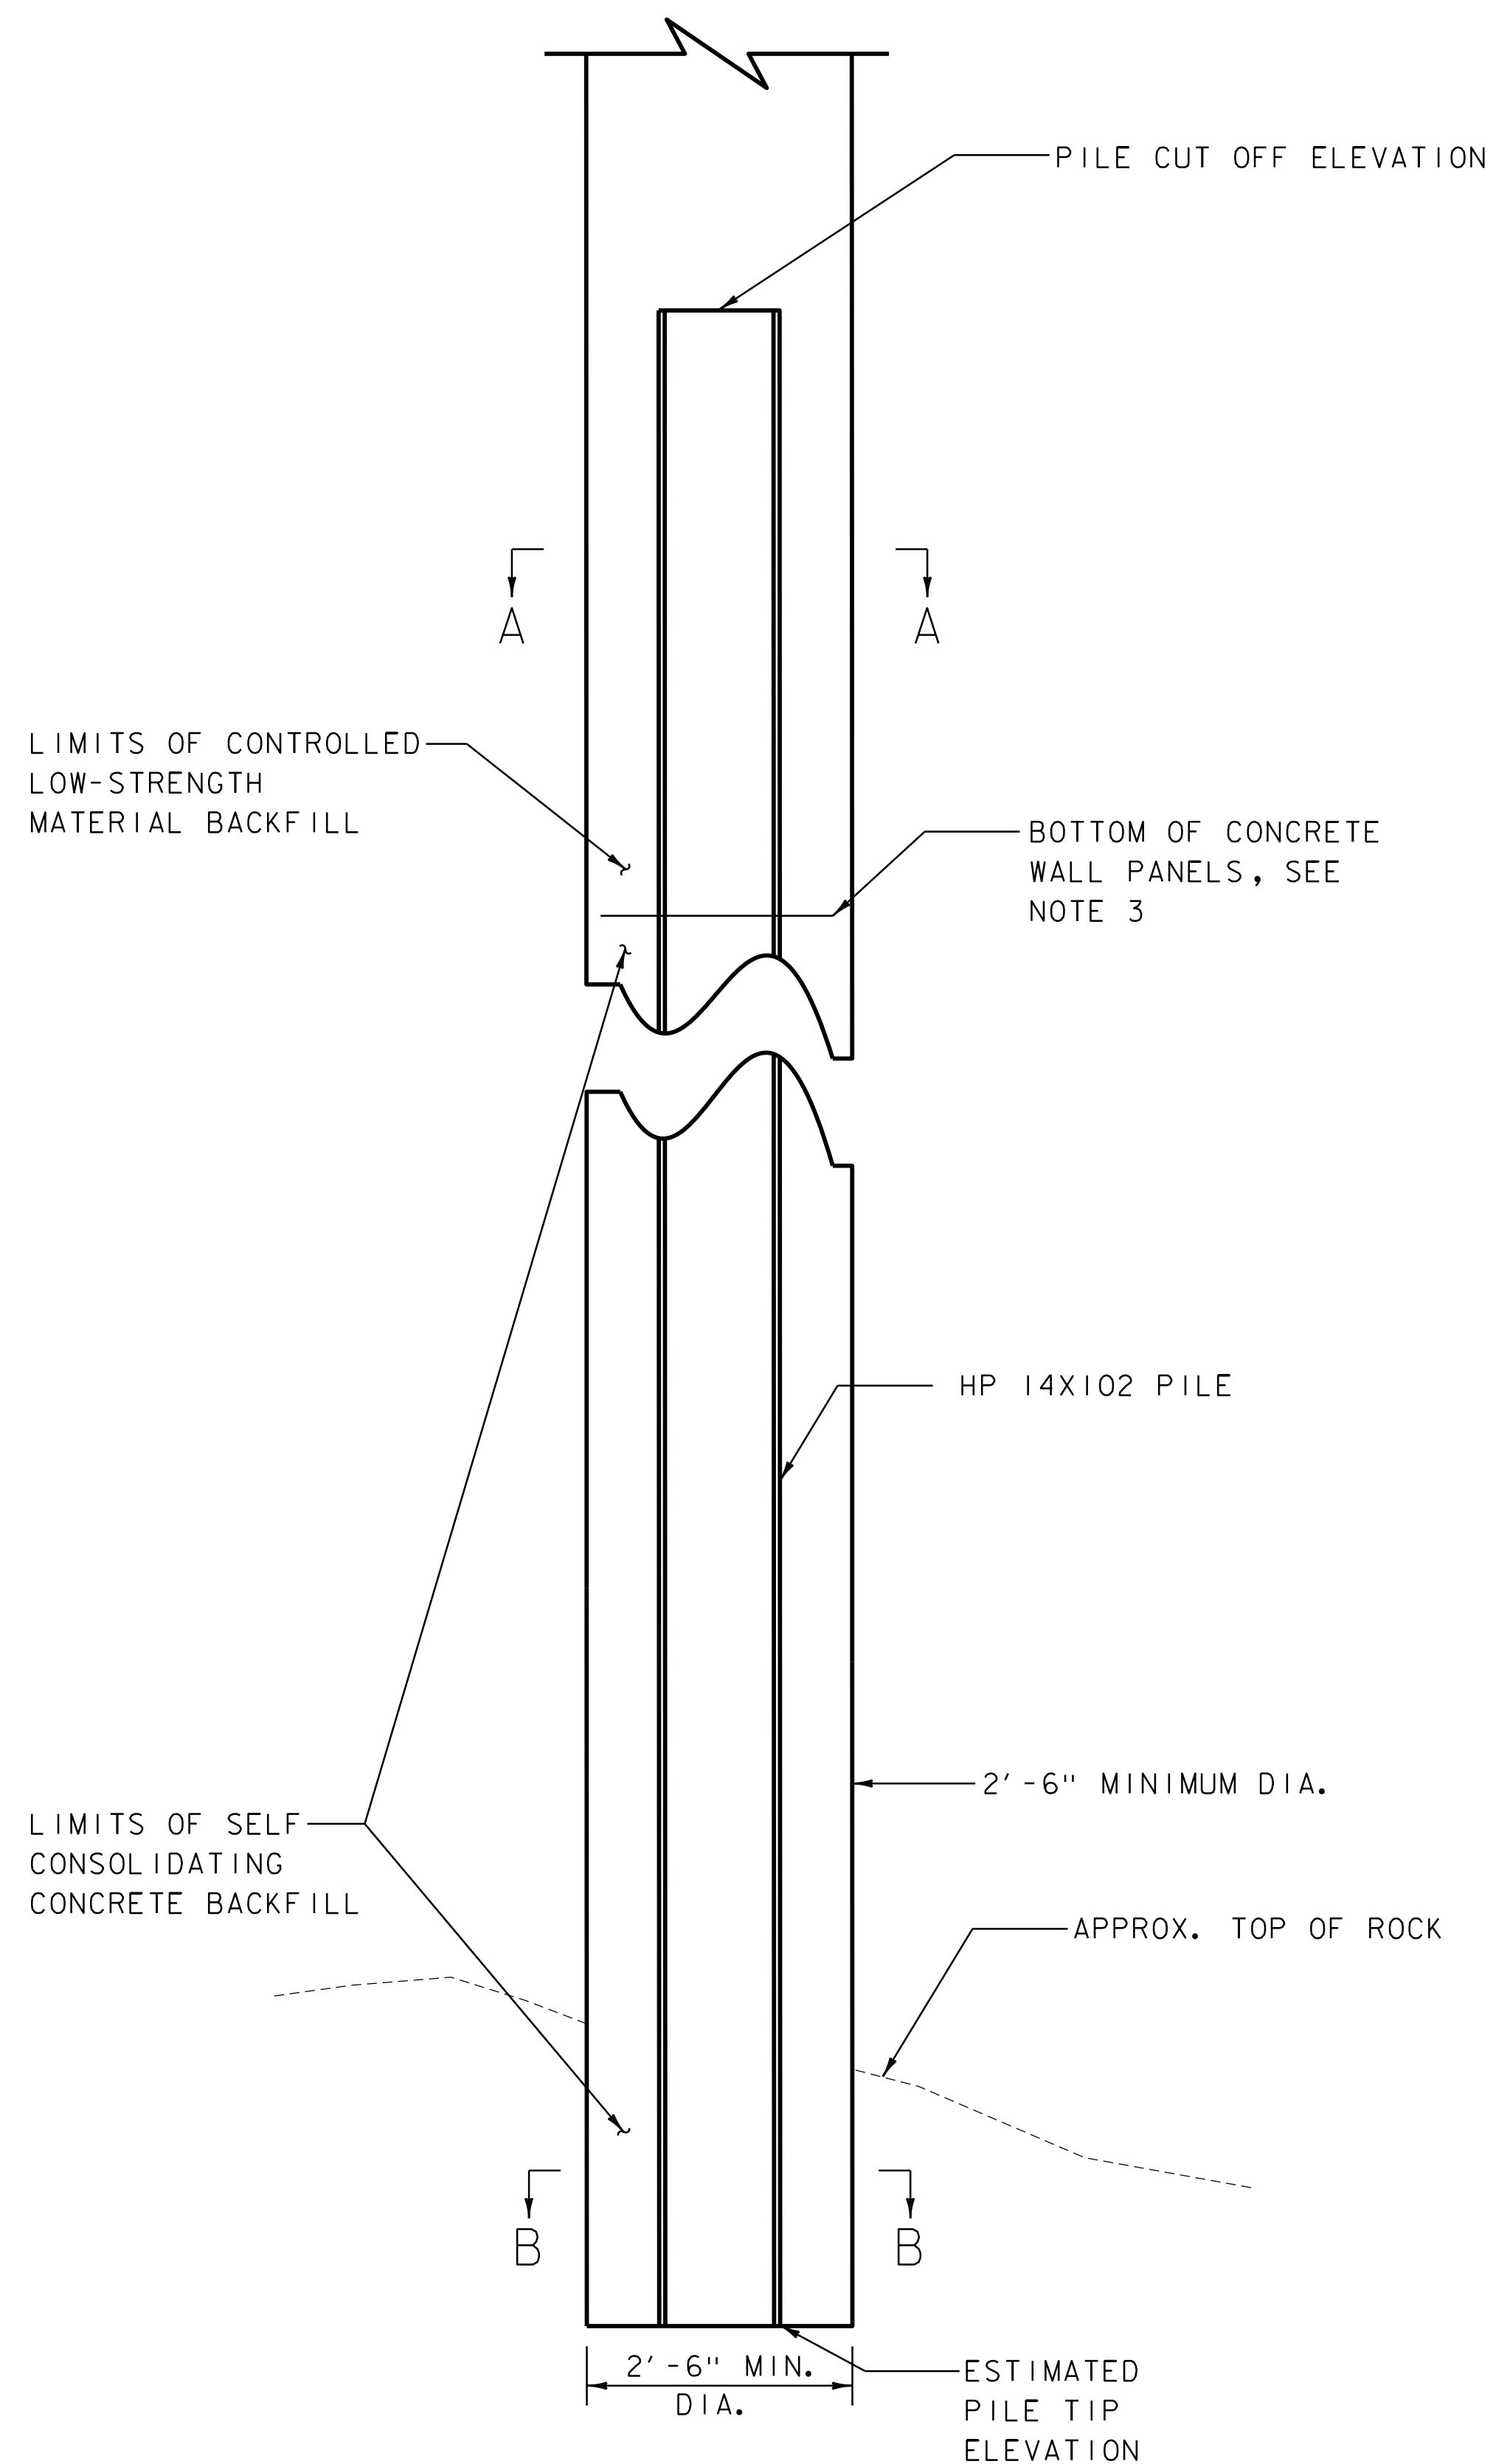

TYPICAL WINGWALL PILE SOCKET DETAIL
(NOT TO SCALE)

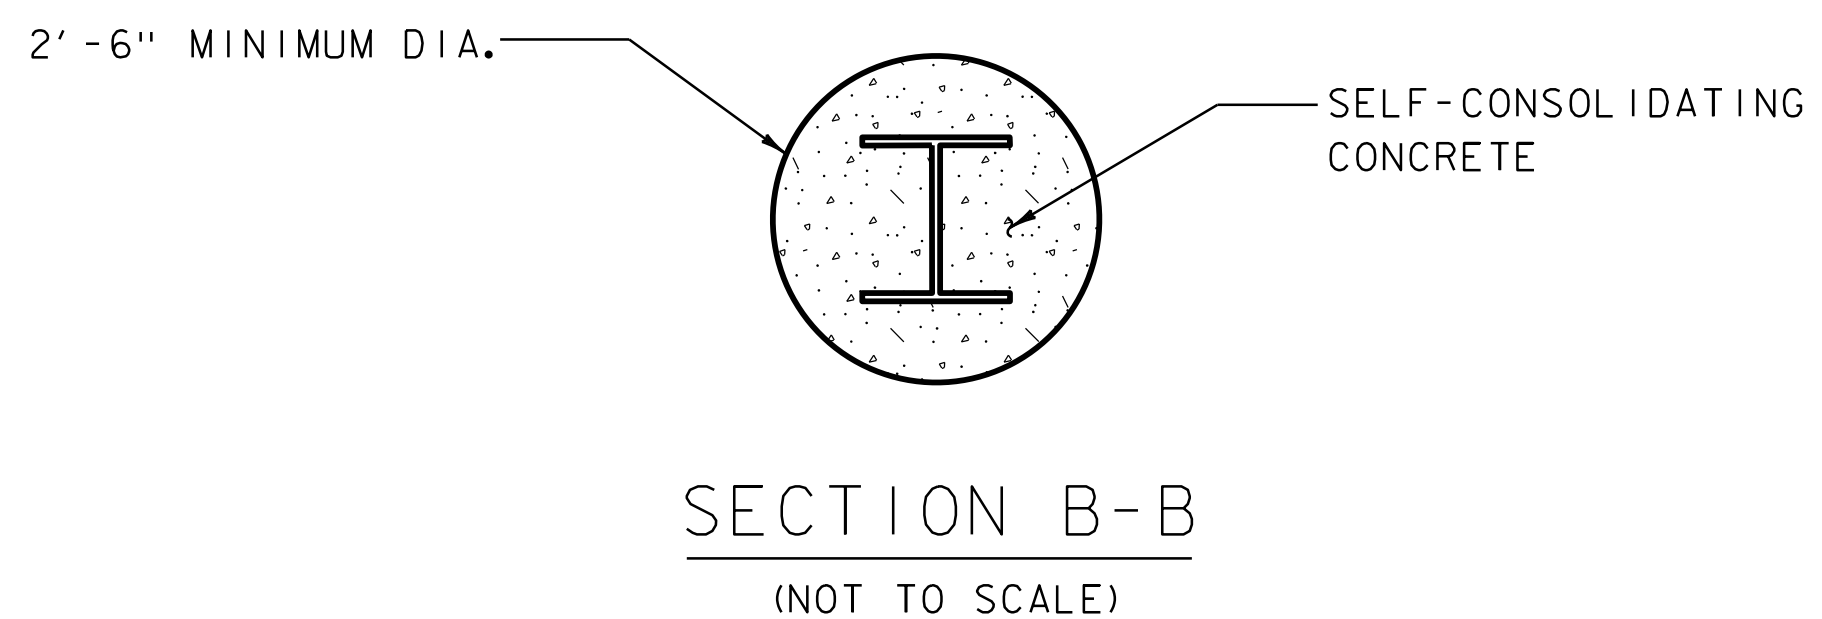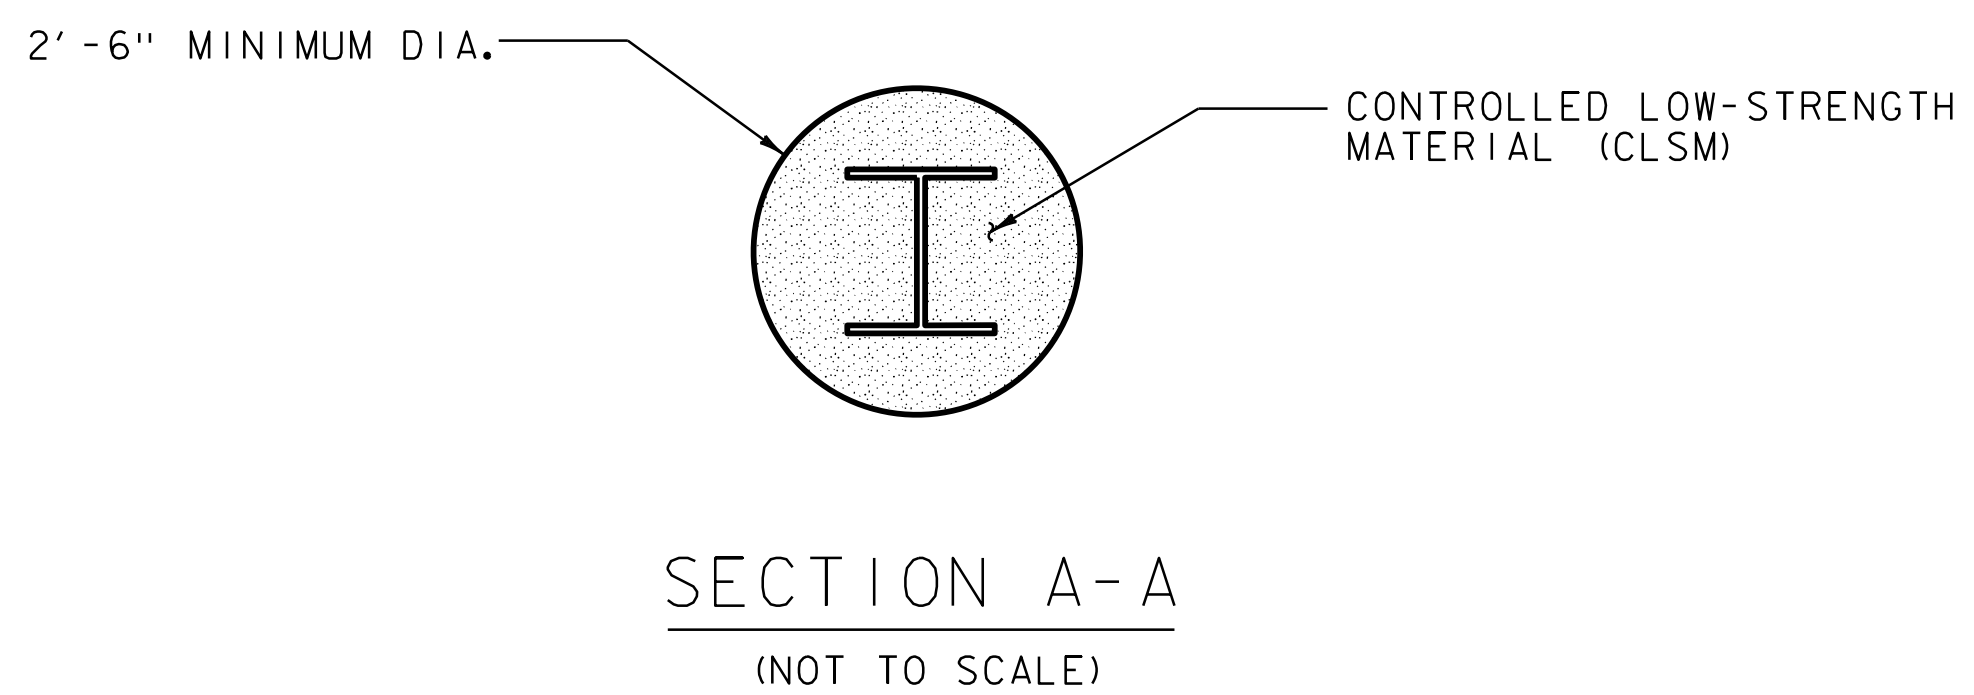

NOTES:

1. FOR ABUTMENT PILE INFORMATION REFER TO 'ABUTMENT PILE DETAIL SHEET'.
2. CONCRETE WALL PANELS NOT SHOWN FOR CLARITY.
3. THE CONTRACTOR SHALL NOTIFY THE ENGINEER IF ROCK IS ENCOUNTERED 5'-0" OR GREATER BELOW THE ESTIMATED TOP OF ROCK ELEVATION AND ABOVE THE MAXIMUM PILE TIP ELEVATION IN SOIL SHOWN IN THE WINGWALL PILE SUMMARY TABLE. DRILLING OPERATIONS SHALL CEASE IF ROCK IS NOT ENCOUNTERED UPON REACHING THE MAXIMUM PILE TIP ELEVATION IN SOIL SHOWN IN THE WINGWALL PILE SUMMARY TABLE AND THE PILE MAY BE TERMINATED AT THAT ELEVATION.
4. PILES WILL BE PLACED WITHIN THE PRE-EXCAVATED PILE SOCKETS, BASES CAST INTO CONCRETE, AND BACKFILLED UTILIZING SPECIFIED MATERIALS. SEATING THE PILES INTO THE BEDROCK SOCKETS WITH AN IMPACT PILE DRIVING HAMMER IS NOT REQUIRED.

WINGWALL PILE SUMMARY TABLE						
SUBSTRUCTURE UNIT	PILE SIZE	MIN. DRILL HOLE DIA. (FT)	ESTIMATED TOP OF ROCK ELEVATION (FT)	REQUIRED ROCK SOCKET LENGTH (FT)	ESTIMATED PILE TIP ELEVATION IN ROCK (FT)	MAXIMUM PILE TIP ELEVATION IN SOIL (FT)
WINGWALL 2	HP 14X102	2.5	700.3	7	693.3	690.0
WINGWALL 3	HP 14X102	2.5	701.6	7	694.6	690.0

ADDENDUM	REVISION	PLOT DATE	DESCRIPTION	BY
△	1	14-MAY-2026	NOTE ADDED	S. BROWN




PROJECT NAME: NORTHFIELD	PLOT DATE: 5/14/2026
PROJECT NUMBER: BF 0241(58)	DRAWN BY: C. JAMISON
FILE NAME: z19j223h_pile_grouting.dgn	CHECKED BY: K. SMITH
PROJECT LEADER: K. SMITH	DESIGNED BY: S. BROWN
WINGWALL PILE DETAIL SHEET	SHEET 60 OF 108

REINFORCING STEEL SCHEDULE

ITEM	EACH	SIZE	LENGTH	MARK	TYPE	A	B	C	D	E	F	G	H	J	K	R	O	ITEM	EACH	SIZE	LENGTH	MARK	TYPE	A	B	C	D	E	F	G	H	J	K	R	O		
DECK																		ABUTMENT 2																			
636	5	36'-10"	S501.2	STR														44	5	40'-0"	2A501.2	STR															
198	5	6'-7"	S502.2	STR														23	5	17'-5"	2A502.2	STR															
28	5	40'-0"	S503.2	STR														21	5	18'-3"	2A503.2	STR															
28	5	16'-8"	S504.2	STR														54	5	8'-0"	2A504.2	STR															
12	5	4'-3"	S505.2	STR														5	5	13'-9"	2A505.2	STR															
18	5	3'-4"	S506.2	STR														5	5	38'-6"	2A506.2	STR															
12	5	2'-6"	S507.2	STR														378	5	4'-6"	2A507.2	2	1'-0"	2'-6"							1'-0"						
* 13	5	1'-9"	S508.2	STR														4	5	12'-8"	2A508.2	2	1'-0"	10'-7"							1'-0"						
568	5	11'-11"	S509.2	1	0'-11"	11'-0"						0'-0"		0'-0"				102	5	13'-0"	2A509.2	S10				2'-6"	5'-3"										
514	5	3'-4"	S510.2	1	0'-11"	2'-5"						0'-0"		0'-0"				7	5	5'-1"	2A510.2	2	1'-0"	3'-1"							1'-0"						
18	5	5'-2"	S511.2	17		3'-4"		1'-2"	0'-8"									28	5	5'-9"	2A511.2	2	1'-6"	2'-9"							1'-6"						
12	5	4'-4"	S512.2	17		2'-6"		1'-2"	0'-8"																												
12	5	3'-7"	S513.2	17		1'-9"		1'-2"	0'-8"									106	8	13'-8"	2A801.2	21	1'-5"	1'-6"	10'-8"												
18	5	8'-6"	S514.2	22		2'-10"		1'-10"	2'-10"				1'-9"	1'-9"	2'-2"	2'-2"		102	8	13'-0"	2A802.2	S10			5'-3"	2'-6"	5'-3"										
286	5	11'-2"	S515.2	S5	0'-8"	1'-2"		8'-1"	0'-7"				0'-8"																								
108	5	7'-7"	S516.2	22		2'-9"		2'-1"	2'-9"				1'-11"	1'-11"	1'-11"	1'-11"																					
WINGWALL 2																		APPROACH SLAB 1																			
9	5	21'-6"	2WW501.2	STR														* 22	5	37'-5"	1EAS501	STR															
20	5	7'-7"	3WW502.2	STR														54	5	5'-7"	1AS502.2	11	0'-11"	1'-5"	0'-6"	2'-9"									0'-3"		
17	5	21'-6"	3WW503.2	STR														* 46	9	19'-9"	1EAS901	1	1'-2"	18'-7"					0'-0"		0'-11"						
5	5	9'-6"	3WW504.2	STR																																	
9	5	23'-6"	2WW505.2	22		12'-9"		10'-9"	0'-0"																												
20	5	15'-6"	2WW506.2	T2	4'-0"	2'-9"		2'-7"	2'-9"	2'-7"		0'-10"		6'-10"	0'-0"	10'-9"	0'-0"																				
WINGWALL 3																		APPROACH SLAB 2																			
6	5	25'-5"	3WW501.2	STR														21	5	37'-5"	2EAS501	STR															
24	5	4'-7"	3WW502.2	STR														54	5	5'-7"	2AS502.2	11	0'-11"	1'-5"	0'-6"	2'-9"									0'-3"		
18	5	7'-7"	3WW503.2	STR														45	9	19'-9"	2EAS901	1	1'-2"	2WW501.2					0'-0"		0'-11"						
6	5	30'-7"	3WW504.2	STR																																	
26	5	11'-6"	3WW505.2	STR																																	
9	5	32'-0"	3WW506.2	STR																																	
3	5	10'-7"	3WW507.2	STR																																	
3	5	19'-4"	3WW508.2	STR																																	
9	5	18'-8"	3WW509.2	22		12'-7"		6'-1"	0'-0"				2'-2"	0'-0"	12'-5"	0'-0"																					
48	5	15'-6"	3WW510.2	T2	4'-0"	2'-9"		2'-7"	2'-9"	2'-7"		0'-10"		0'-0"	0'-0"	12'-5"	0'-0"																				
ABUTMENT 1																		MOMENT SLAB																			
44	5	40'-0"	1A501.2	STR														▲ 44	5	10'-10"	MS501.2	STR															
23	5	17'-5"	1A502.2	STR														▲ 100	5	10'-0"	MS502.2	STR															
21	5	18'-3"	1A503.2	STR														▲ 88	6	12'-5"	MS601.2	S10			0'-8"	1'-8"	10'-1"										
54	5	8'-1"	1A504.2	STR														BRIDGE RAIL																			
5	5	13'-9"	1A505.2	STR														24	5	12'-10"	BR501.2	S5	0'-6"	5'-4"	1'-2"	5'-4"									0'-6"		
5	5	38'-6"	1A506.2	STR														48	5	8'-10"	BR502.2	S5	0'-6"	3'-4"	1'-2"	3'-4"									0'-6"		
378	5	4'-6"	1A507.2	2	1'-0"	2'-6"							1'-0"					380	5	7'-7"	BR503.2	S5	0'-6"	2'-8"	1'-2"	2'-9"									0'-6"		
4	8	12'-5"	1A508.2	2	1'-0"	10'-5"							1'-0"																								
102	5	12'-8"	1A509.2	S10				5'-1"	2'-6"	5'-1"																											
7	5	5'-1"	1A510.2	2	1'-0"	3'-1"							1'-0"																								
28	5	5'-9"	1A511.2	2	1'-6"	2'-9"							1'-6"																								
106	8	13'-5"	1A801.2	21	1'-5"	1'-6"	10'-6"																														
* 103	8	12'-8"	1A802.2	S10				5'-1"	2'-6"	5'-1"																											

~ NOTES ~

- UNLESS OTHERWISE DESIGNATED, ALL BAR REINFORCEMENT FOR CONCRETE IN SIZES UP TO AND INCLUDING NO. 18 SHALL CONFORM TO THE REQUIREMENTS OF THE "SPECIFICATIONS FOR DEFORMED BILLET-STEEL BARS FOR CONCRETE REINFORCEMENT", AASHTO M 31 (ASTM A 615-S). ALL BARS SHALL BE GRADE 60, UNLESS OTHERWISE DESIGNATED.
- FOR TYPICAL BENDING DETAILS, RECOMMENDED PIN DIAMETER "D" OF BENDS AND HOOKS, AND OTHER STANDARD PRACTICE, SEE CURRENT CONCRETE REINFORCING STEEL INSTITUTE "MANUAL OF STANDARD PRACTICE".
- BARS WHICH REQUIRE MORE ACCURATE BENDING THAN STANDARD PRACTICES SHOULD HAVE LIMITS INDICATED.
- ALL DIMENSIONS ARE OUT TO OUT OF BAR EXCEPT "A" AND "G" ON STANDARD 180 DEGREE AND 135 DEGREE HOOKS.
- "J" DIMENSION ON 180 DEGREE HOOKS TO BE SHOWN ONLY WHERE NECESSARY TO RESTRICT HOOK SIZE. OTHERWISE, STANDARD HOOKS ARE TO BE USED.
- "H" DIMENSION ON STIRRUPS TO BE SHOWN ONLY WHEN NECESSARY TO MAINTAIN CLEARANCES.
- WHERE SLOPE DIFFERS FROM 45 DEGREES, DIMENSIONS "H" AND "K" MUST BE SHOWN.
- ▲ DENOTES BARS TO BE CUT IN FIELD.
- * DENOTES ONE EXTRA BAR ADDED FOR TESTING PURPOSES.
- △ DENOTES TWO EXTRA BARS ADDED FOR TESTING PURPOSES.
- E IN BAR MARK PREFIX DENOTES EPOXY COATED REINFORCING STEEL.

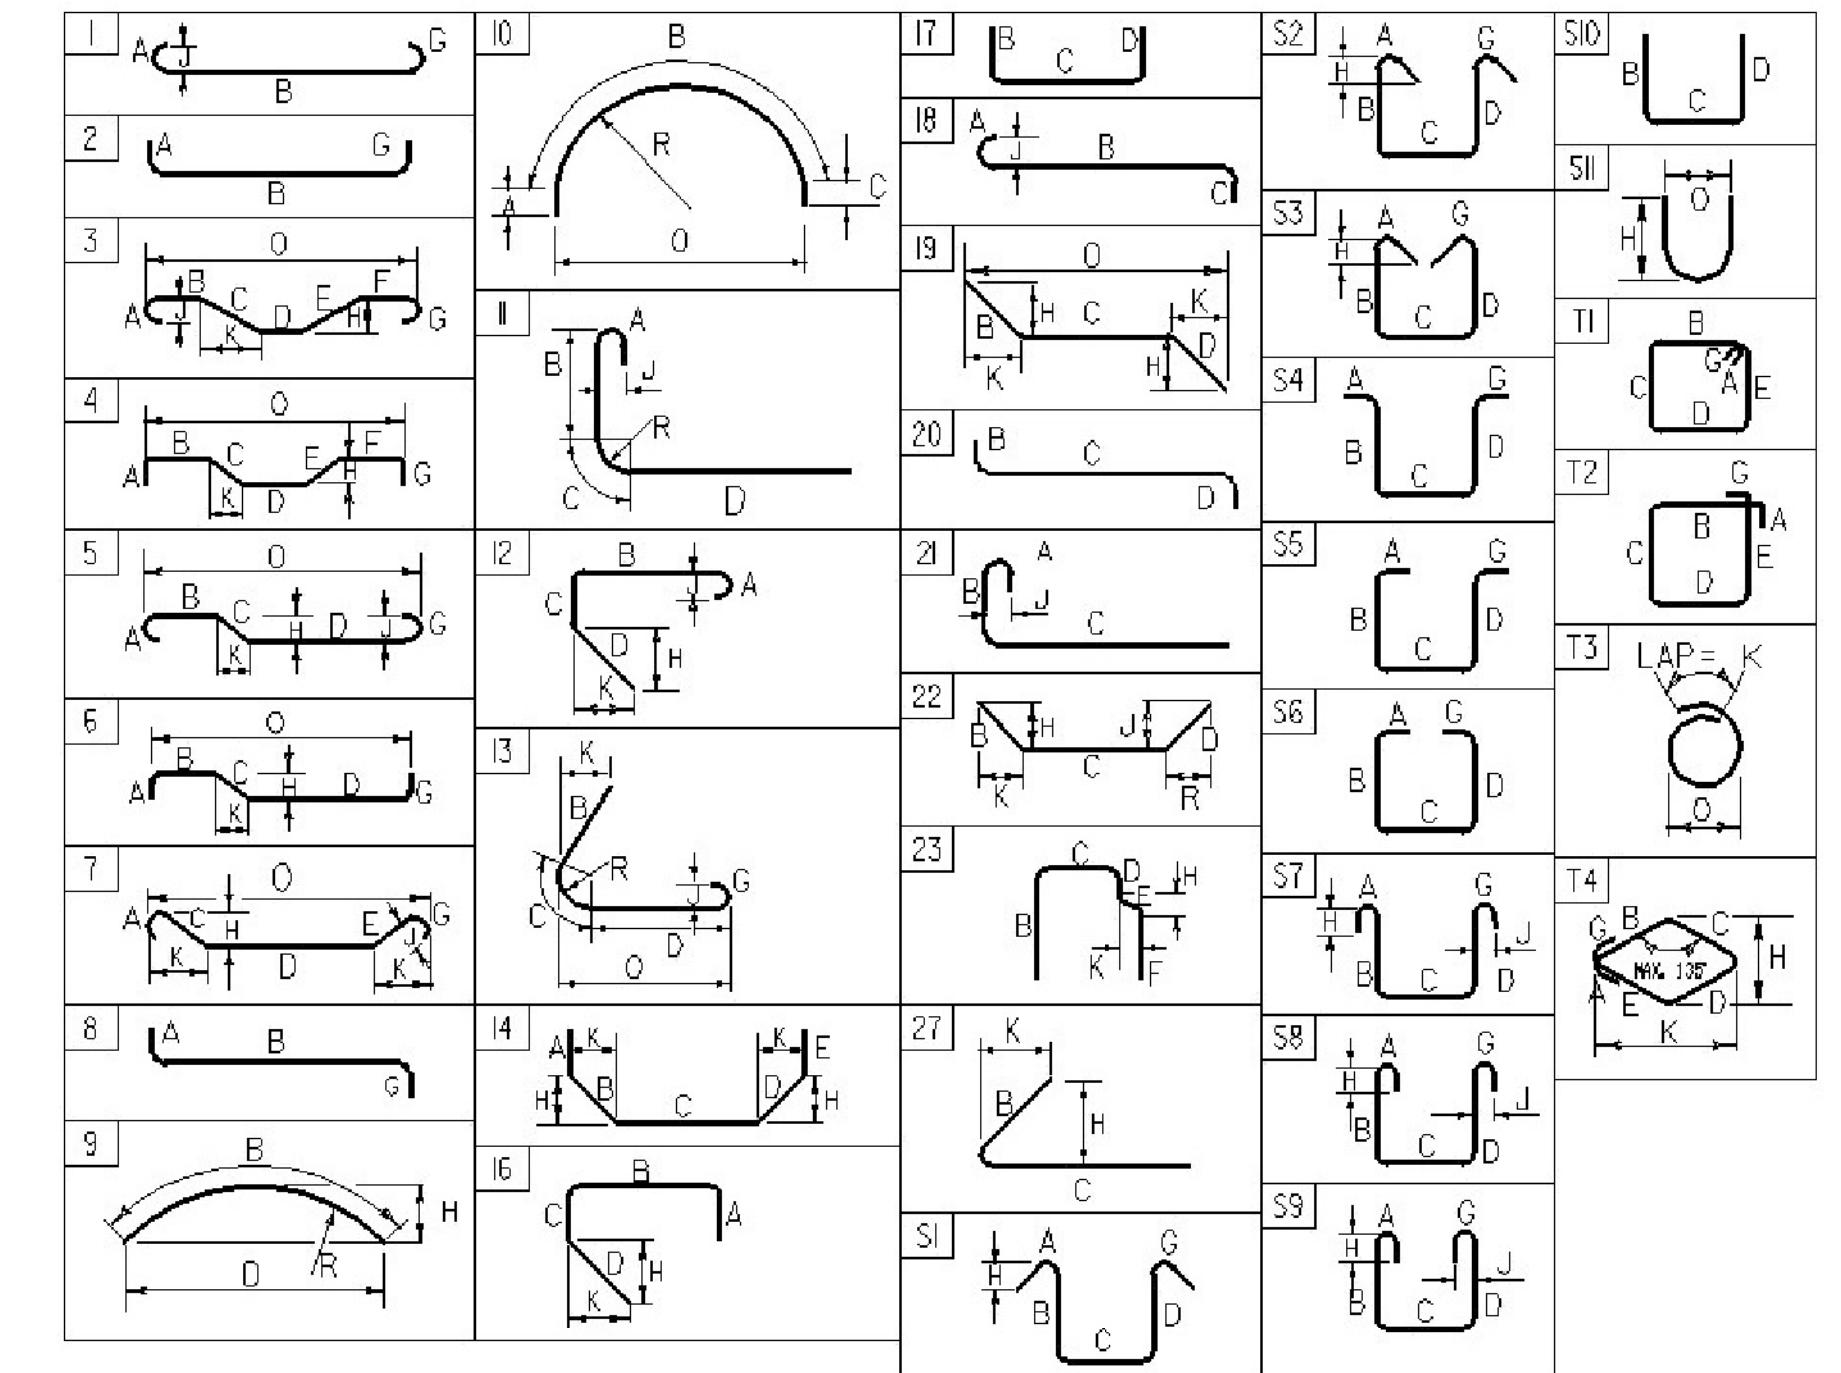

ASTM STANDARD REINFORCING BARS

BAR SIZE DESIGNATION	WEIGHT POUNDS PER FOOT	NOMINAL DIMENSIONS ROUND SECTION		
		DIAMETER INCHES	AREA INCHES ²	PERIMETER INCHES
#3	0.376	0.375	0.11	1.178
#4	0.668	0.500	0.20	1.571
#5	1.043	0.625	0.31	1.963
#6	1.502	0.750	0.44	2.356
#7	2.044	0.875	0.60	2.749
#8	2.670	1.000	0.79	3.142
#9	3.400	1.128	1.00	3.544
#10	4.303	1.270	1.27	3.990
#11	5.313	1.410	1.56	4.430
#14	7.65	1.693	2.25	5.32
#18	13.60	2.257	4.00	7.09

~ REINFORCING STEEL CORROSION RESISTANCE LEVEL ~

THE REINFORCING STEEL MARKS IN THIS SCHEDULE INDICATE THE REQUIRED BAR CORROSION RESISTANCE LEVEL. CORROSION RESISTANCE LEVEL IS DENOTED WITH A .2 FOR LEVEL TWO SUFFIX OR .3 FOR LEVEL THREE SUFFIX. .1 FOR LEVEL ONE IS TO BE OMITTED. THE BAR MATERIAL TYPE AND BAR STEEL GRADE PROVIDED FOR EACH CORROSION LEVEL WILL BE RECORDED ON THE PLAN SET PI SHEET FOR AS-BUILT RECORD PLAN ARCHIVES.

ADDENDUM	REVISION	PLOT DATE	DESCRIPTION	BY
△	I	14-MAY-2026	REINFORCING REVISED	S. BROWN

PROJECT NAME: NORTHFIELD
PROJECT NUMBER: BF 024I(58)
FILE NAME: z19j223rbor.dgn
PROJECT LEADER: K. SMITH
DESIGNED BY: S. BROWN
WINGWALL 3 DETAILS

PLOT DATE: 5/14/2026
DRAWN BY: D. WELLS
CHECKED BY: K. SMITH
SHEET 75 OF 108

SPECIAL PROVISIONS

1. NOTICE TO BIDDERS – CONTRACT COMPLETION DATE. This Contract shall be completed on or before October 29, 2027.
2. NOTICE TO BIDDERS – INCENTIVE/DISINCENTIVE (I/D). In accordance with Subsection 108.10 and as described below, there shall be an Incentive/Disincentive period on this Contract.
 - (a) Dates and Meetings. The allowable I/D work period shall start at 7:00 a.m. and end 84 days later by 6:59 a.m. This 84 day work period is herein defined as the I/D period. The I/D period shall begin on June 1, 2027 at 7:00 a.m. and it shall end no later than August 24, 2027 at 6:59 a.m..

During the I/D period, the Contractor will be allowed to work on the project for 24 hours per day, 7 days per week, including holiday periods. Night work will be allowed during the I/D period. See Notice to Bidders No. 4 & 5 for additional information and requirements regarding night work and noise restrictions.

For this Contract, a public information meeting shall be held prior to the start of the I/D period, as described in Subsection 108.10(b).

- (b) Identified Work. All work identified below shall be completed before the end of the I/D period:
 - (1) Bridge deck, bridge sidewalk, bridge rail, and approach slabs cast and cured for a minimum of 7 days, and attained the concrete compressive strengths specified in Subsection 501.16(b).
 - (2) Restore Depot Square to original motor vehicle traffic flow configuration.
 - (3) Type IIS base course and the Type IIS intermediate course of pavement shall be placed and compacted through the project limits. Temporary pavement transverse tapers shall be installed at the begin and end of bridge deck, and at the existing pavement match locations.
 - (4) Wingwalls #1 and #4 shall be installed and backfilled.
 - (5) Construction of the portion of proposed water main that is supported by the superstructure.
 - (6) The bridge and roadway shall be opened to two way traffic (two 12 foot lanes and two 2 foot shoulders) with temporary delineation.

52. NOTICE TO BIDDERS – SUBSECTION 103.04(e). Subsection 103.04(e) is hereby modified by deleting the sentence “Limits of coverage shall not be less than \$2,000,000 per occurrence or claim and \$2,000,000 in the aggregate.” from the second paragraph and replacing it with the sentence “Limits of coverage shall not be less than \$1,000,000 per occurrence or claim and \$1,000,000 in the aggregate.”.
53. NOTICE TO BIDDERS – SUBSECTION 230.05. Subsection 230.05 is hereby modified by being deleted in its entirety and replaced with the following:

SECTION 230.05 METHOD OF MEASUREMENT. The quantity of Disposal of Contaminated Materials (N.A.B.I.) to be measured for payment will be the cost, in dollars, of the work to reduce the size of stone within the material to a size that is acceptable to the disposal receiving facility, loading the material for disposal, trucking materials to a disposal facility plus the cost, in dollars, of disposing of the contaminated materials at the disposal facility. Costs will be calculated on a force account basis in accordance with Subsection 109.06. When performed by the Contractor, trucking costs will be calculated in accordance with Subsection 109.06(c) and labor costs will be calculated in accordance with Subsection 109.06(a). When performed by a subcontractor, trucking will be considered subcontracted work in accordance with Subsection 109.06(d). The cost of disposal, as determined from disposal facility receipts, will be considered subcontracted work in accordance with Subsection 109.06(d). Bills of lading or waste manifests, disposal facility receipts, and slips describing the type of trucking equipment and hours of use shall be furnished to the Engineer for each load delivered to a disposal facility.

The quantity of Reuse of Contaminated Materials to be measured for payment will be the number of cubic yards of material stockpiled and reused in the complete and accepted work.

The quantity of the Project Operations Plan and the Project Operations Completion Report will be paid for on a lump sum basis for the complete and accepted work.

The quantity of Environmental Oversight to be measured for payment will be the number of hours of field work as documented in the reviewed and accepted field reports.

When specified to be measured on a lump sum basis, the quantity of Management of Contaminated Groundwater to be measured for payment will be on a lump sum basis for the complete and accepted work.

When specified to be measured by volume, the quantity of Management of Contaminated Groundwater to be measured for payment will be the number of thousand gallons (MGAL) of water managed in the complete and accepted work.

54. **NOTICE TO BIDDERS – SUBSECTION 230.06.** Subsection 230.06 is hereby modified by being deleted in its entirety and replaced with the following:

SECTION 230.06 BASIS OF PAYMENT. Payment for Disposal of Contaminated Materials (N.A.B.I.) will be full compensation for the work to reduce the size of stone within the material to a size that is acceptable to the receiving facility, loading the materials for disposal, trucking costs, disposal facility tipping fees, and district solid waste fees.

A value in dollars has been included in the bid proposal for Disposal of Contaminated Materials (N.A.B.I.). This amount will be adjusted to the actual cost of reducing the size of stone and unreinforced concrete within the material to a size that is acceptable to the receiving facility, loading the materials, trucking and disposal, after review and approval of trucking slips and paid invoices. No additional payment will be made under this item.

The accepted quantity of Reuse of Contaminated Materials will be paid for at the Contract unit price per cubic yard. Payment will be full compensation for handling, segregating, and installing the materials specified, and for furnishing all labor, tools, equipment, and incidentals necessary to complete the work. Costs for the initial excavation of materials will be paid for under the appropriate excavation items included in the Contract.

The accepted quantity of Project Operations Plan will be paid for at the Contract lump sum price. Payment will be full compensation for preparing, submitting, and revising, based on Agency comments, a report that meets the requirements set forth in the Contract, and subsequent management of the project site, including protecting stockpiles, decontamination of trucks and equipment, coordination and other activities required to maintain the site in compliance with the POP.

The accepted quantity of Project Operations Completion Report will be paid for at the Contract lump sum price. Payment will be full compensation for completing any required waste profiles for receiving facility acceptance; reviewing manifests and bills of lading for contaminated soils; coordinating and administering documentation and reimbursement submittals; and for providing all labor, management, administration, laboratory analysis, and incidentals necessary to complete the work.

The accepted quantity of Environmental Oversight will be paid for at the Contract unit price per hour. Payment will be full compensation for preparing daily field reports, field screening of excavated soil, collection of all samples, documentation of dewatering and groundwater treatment activities, and for providing all labor, equipment, and supplies necessary to complete the work.

The accepted quantity of Management of Contaminated Groundwater will be paid for at the Contract lump sum price or at the Contract unit price per thousand gallons (MGAL), as applicable. Payment will be full compensation for mobilization, installation, startup, operation, maintenance, monitoring, demobilization, decontamination, and proper disposal

of all treatment media and residuals, and for providing all materials, labor, tools, equipment, and incidentals necessary to complete the work.

- (a) Partial payments for Project Operations Plan will be made as follows:**
 - (1) The first payment of 50% of the lump sum price will be paid upon acceptance of the Project Operations Plan by the Agency.**
 - (2) The remaining 50% of the lump sum price will be paid when disposal activities are complete or stockpile areas have been closed out, whichever is later.**

- (b) Partial payments for Management of Contaminated Groundwater paid by the lump sum will be made as follows:**
 - (1) The first payment of 50% of the lump sum price will be paid when the liquid treatment system is permitted, delivered to the site, and made fully operational.**
 - (2) The remaining 50% of the lump sum price will be paid when the liquid treatment system is fully removed from the site and demobilized.**